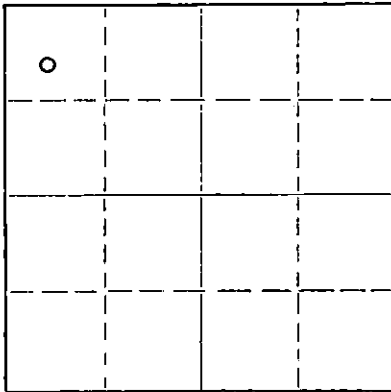


STATE OF KANSAS
STATE CORPORATION COMMISSION

Give All Information Completely
Make Required Affidavit
Mail or Deliver Report to:
Conservation Division
State Corporation Commission
211 No. Broadway
Wichita, Kansas

WELL PLUGGING RECORD

NORTH

Locate well correctly on above
Section Plat

Finney County. Sec. 21 Twp. 21S Rge. (E) 30 (W)
Location as "NE/CNW/SW" or footage from lines C NW NW
Lease Owner Sun Oil Company
Lease Name Ruth Heim Well No. 1
Office Address Box 1348, Tulsa, Oklahoma
Character of Well (completed as Oil, Gas or Dry Hole) Dryhole
Date well completed 3-21- 19 64
Application for plugging filed 3-21- 19 64
Application for plugging approved 3-21- 19 64
Plugging commenced 3-21- 19 64
Plugging completed 3-21- 19 64
Reason for abandonment of well or producing formation dryhole

If a producing well is abandoned, date of last production 19
Was permission obtained from the Conservation Division or its agents before plugging was commenced? Yes

Name of Conservation Agent who supervised plugging of this well Mr. Hugh Scott, Sublette, Kansas
Producing formation None Depth to top Bottom Total Depth of Well Feet
Show depth and thickness of all water, oil and gas formations.

OIL, GAS OR WATER RECORDS

CASING RECORD

FORMATION	CONTENT	FROM	TO	SIZE	PUT IN	PULLED OUT
None				8-5/8"	328'	None

Describe in detail the manner in which the well was plugged, indicating where the mud fluid was placed and the method or methods used in introducing it into the hole. If cement or other plugs were used, state the character of same and depth placed, from feet to feet for each plug set.

March 21, 1964: Hole full of 9.8# mud. Spotted 25 sax cement 640' to 720';
25 sax cement 230-300'; 15 sax cement 0-45'.

RECEIVED
STATE CORPORATION COMMISSION

APR 8 1964

CONSERVATION DIVISION
Wichita, Kansas

4-8-64

(If additional description is necessary, use BACK of this sheet)

Name of Plugging Contractor Murfin Drilling Company
Address 617 Union Center, Wichita 2, Kansas

STATE OF OKLAHOMA, COUNTY OF TULSA, ss.

J. H. Allen (employee of owner) or (owner or operator) of the above-described well, being first duly sworn on oath, says: That I have knowledge of the facts, statements, and matters herein contained and the log of the above-described well as filed and that the same are true and correct. So help me God.

(Signature)

Box 1348, Tulsa, Oklahoma
(Address)

SUBSCRIBED AND SWORN TO before me this 6th day of April, 1964

MAR 16 1968

My commission expires

DORIS SUTTERFIELD

Notary Public.

WELL LOG
SUN OIL COMPANY
Ruth Heim No. 1
C NW NW Sec. 21-21-30W
Finney County, Kansas

<u>FORMATION</u>	<u>From</u>	<u>To</u>
Clay & sand	0	130
Shale	130	330
Sand & shale	330	1495
Anhydrite	1495	1540
Shale	1540	2070
Anhydrite & shale	2070	2487
Lime & shale	2487	2695
Sand, lime & shale	2695	3342
Shale & lime	3342	3686
Topeka Lime & shale	3686	3962
Heebner Shale & lime	3962	4006
Lansing Lime	4006	4438
Marmaton Lime (w/strks sh)	4438	4592
Cherokee Lime & shale	4592	4671
Miss. Lime & shale	4671	4682
St. Louis Lime & shale	4682	4844
		T.D.

CASING RECORD:

8-5/8" set at 328' and cemented
to ground level w/250 sacks.

RECEIVED
STATE CORPORATION COMMISSION

APR 8 1964

CONSERVATION DIVISION
Wichita, Kansas

DRY AND ABANDONED.

I hereby certify that the foregoing is a true and correct copy of the Ruth Heim No. 1 well log as recorded on the books of Sun Oil Company, Tulsa, Oklahoma.


J. H. Allen

STATE OF OKLAHOMA)
COUNTY OF TULSA) SS

Subscribed and sworn to before me this 6th day of April, 1964.


Notary Public

My Commission Expires:

3-16-68