

STATE OF KANSAS
STATE CORPORATION COMMISSION
200 Colorado Derby Bldg.
Wichita, Kansas 67202


Form CP-4
Rev. 12-15-80

API #15-055-20,527-0000

WELL PLUGGING RECORD

Give All Information Completely
Make Required Affidavit

COUNTY Finney SEC. 32 TWP. 21S RGE. 30 E 10
Location as in quarters or footage from lines:
NW/4 NW/4 NE/4

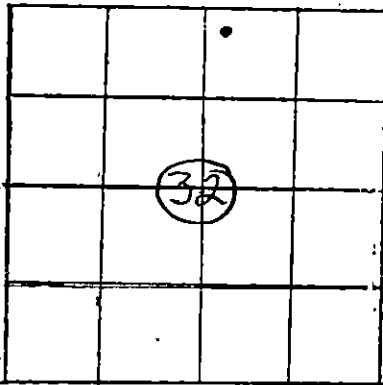

Locate Well
correctly on above
Section Platt.

Lease Owner Ladd Petroleum Corporation
Lease Name Rissler Well No. 1
Office Address P. O. Box 2848, Tulsa, Oklahoma 74101
Character of Well (Completed as Oil, Gas or Dry Hole): Junked Hole
Date Well Completed 1-18-83
Application for plugging filed Yes
Plugging commenced 1-17-83
Plugging completed 1-18-83
Reason for abandonment of well or producing formation Lost circulation while drilling
Was permission obtained from the Conservation Division or it's Agent's before plugging was commenced? Yes

Name of Conservation Agent who supervised plugging of this well Steve Durrant
Producing formation None Depth to top bottom T.D. 5269'
Show depth and thickness of all water, oil and gas formations.

OIL, GAS OR WATER RECORDS

Casing Record

Formation	Content	From	To	Size	Put in	Pulled Out
				8 5/8	630	None

Describe in detail the manner in which the well was plugged, indicating where the mud fluid was placed and the method or methods used in introducing it into the hold. If cement or other plugs were used, state the character of same and depth placed, from feet to feet for each plug set.

- 1) Spot 100 sx cmt @ 1645'. WOC & tag top of plug @ 1057'.
- 2) Spot 100 sx cmt @ 1057'. WOC & tag top of plug @ 860'.
- 3) Spot 100 sx cmt @ 860'. WOC & tag top of plug @ 530'.
- 4) Spot 10 sx w/ rubber plug @ 50'.
- 5) Put 10 sx in rat hole & 10 sx in mouse hole.

2-4-83

All cement "Dowell" RFC 10-2

RECEIVED
STATE CORPORATION COMMISSION

FEB 4 1983

(If additional description is necessary, use BACK of this sheet)

Name of Plugging Contractor Leben Drilling Co.

CONSERVATION DIVISION
Wichita, Kansas

STATE OF Oklahoma COUNTY OF Tulsa, ss.
K. D. Miller (employee of owner) ~~xxx (owner) xxx operator~~ of the
above-described well, being first duly sworn on oath, says: That I have knowledge of the
facts, statements, and matters herein contained and the log of the above-described well as
filed and that the same are true and correct. So help me God.

(Signature) K. D. Miller
Box 2848, Tulsa, OK 74101
(Address)

SUBSCRIBED AND SWORN TO before me this 28 day of January, 19 83

Dwight Lee Campbell
Notary Public.

My Commission expires: June 11, 1983