


Give All Information Completely
Make Required Affidavit
Mail or Deliver Report to:
Conservation Division
State Corporation Commission
800 Biting Building
Wichita, Kansas

WELL PLUGGING RECORD

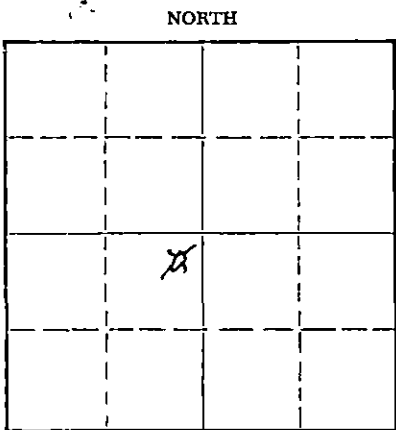

Locate well correctly on above
Section Plat

Mc Pherson County, Sec. 10 Twp. 21 Rge. 1 (#) (W)
Location as "NE/CNW/SW" or footage from lines NE SW
Lease Owner Don C. Slawson
Lease Name Schroeder Well No. 1
Office Address 502 Central Bldg.
Character of Well (completed as Oil, Gas or Dry Hole) Dry
Date well completed May 10 19 59
Application for plugging filed " 19 " "
Application for plugging approved "Oral" 19 "
Plugging commenced " 19 "
Plugging completed " 19 "
Reason for abandonment of well or producing formation _____

If a producing well is abandoned, date of last production _____ 19 ____
Was permission obtained from the Conservation Division or its agents before plugging was commenced? Yes-oral

Name of Conservation Agent who supervised plugging of this well G. J. Tolmen
Producing formation _____ Depth to top _____ Bottom _____ Total Depth of Well 3494 Feet
Show depth and thickness of all water, oil and gas formations.

OIL, GAS OR WATER RECORDS

CASING RECORD

FORMATION	CONTENT	FROM	TO	SIZE	PUT IN	PULLED OUT
				8 5/8"	202'	none

Describe in detail the manner in which the well was plugged, indicating where the mud fluid was placed and the method or methods used in introducing it into the hole. If cement or other plugs were used, state the character of same and depth placed, from _____ feet to _____ feet for each plug set.

Filled hole full heavy mud to 190 ft.
Drove plug to 190 ft.
Dumped in 20 sacks cement. Finished filling hole to within 40 ft. of top of surface pipe, then dumped in 10 sacks cement--2 sacks in rat hole

RECEIVED
STATE CORPORATION COMMISSION
MAY 13 1959
CONSERVATION DIVISION
Wichita, Kansas

(If additional description is necessary, use BACK of this sheet)

Name of Plugging Contractor Mallard Drilling Company
Address 419 Union Natl. Bldg.

STATE OF Kansas COUNTY OF Sedgwick, ss.
C. C. Nelson, partner (employee of, owner, or operator) of the above-described well, being first duly sworn on oath, says: That I have knowledge of the facts, statements, and matters herein contained and the log of the above-described well as filed and that the same are true and correct. So help me God.

(Signature) C. C. Nelson
419 Union Natl. Bldg.
(Address)

SUBSCRIBED AND SWORN TO before me this 12th day of May, 19 59

Edward J. Sarge Notary Public.

My commission expires March 12, 1962

PLUGGING
FILE SEC. 10 T. 21 R. 1W
BOOK PAGE 38 LINE 17

COMPANY: Don G. Clawson
 CONTRACTOR: Mallard Drilling Company
 WELL: Schroeder #1
 LOCATION: NE SW Sec. 10-21-1W
 McPherson County, Kansas
 COMMENCED: May 1, 1959
 COMPLETED: May 10, 1959

0	to	70	Sand
70	to	202	Shale and shells
202	to	500	Shale and lime
500	to	880	Lime
880	to	1535	Shale and lime
1535	to	2025	Shale and lime
2025	to	2170	Lime
2170	to	2339	Shale and lime
2339	to	2575	Lime
2575	to	2960	Shale and lime
2960	to	3280	Mississippi - lime
3280	to	3460	Shale and lime
3460	to	3494	Shale
		3494	T.D.

RECEIVED
 STATE CORPORATION COMMISSION
 MAY 13 1959
 CONSERVATION DIVISION
 Wichita, Kansas

Set 202 feet of 8 5/8" surface pipe. Cemented with 140 sacks cement.

TOPS: K.C. 2339 Chat 2949 Viola 3471 Elevation 1516--K.M.
 Measurements taken from T.D.D. P.D.D. 5' from ground level.

DEK, ABANDONED AND PLUGGED

CERTIFICATE

I, G. C. Nelson, do hereby certify that the above and foregoing is a true and correct copy of log of the Schroeder #1, McPherson County, Kansas, as reflected by files of the Mallard Drilling Company.

G. C. Nelson

Subscribed and sworn to before me a Notary Public, within and for Sedgewick County, Kansas, this 13 day of May 1959.

Earl P. Sage

My commission expires March 18, 1959

PLUGGING	
FILE	SEC. 10 T. 21 R. 4W
BOOK	PAGE 38 LINE 17