


WELL PLUGGING RECORD

Give All Information Completely
Make Required Affidavit
Mail or Deliver Report to:
Conservation Division
State Corporation Commission
211 No. Broadway
Wichita, Kansas

McPherson County. Sec. 10 Twp. 21 Rge. 1 (E) 1 (W)
Location as "NE/CNW%SW%" or footage from lines C NE NE SE
Lease Owner Donald T. Ingling et al
Lease Name Richert Well No. 1
Office Address 615 First National Bldg., Wichita 2, Kansas
Character of Well (completed as Oil, Gas or Dry Hole) Dry Hole
Date well completed July 15, 19 62
Application for plugging filed July 15, 19 62
Application for plugging approved July 15, 19 62
Plugging commenced July 15, 19 62
Plugging completed July 16, 19 62
Reason for abandonment of well or producing formation dry

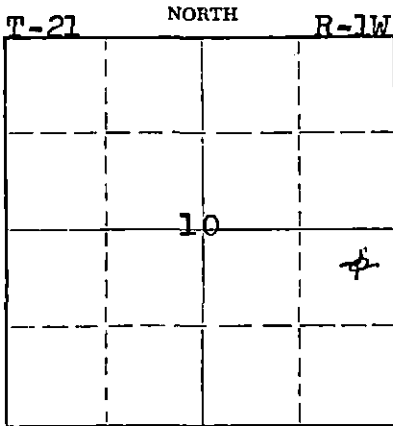

Locate well correctly on above Section Plat

If a producing well is abandoned, date of last production 19
Was permission obtained from the Conservation Division or its agents before plugging was commenced? Yes

Name of Conservation Agent who supervised plugging of this well Gilbert Toman
Producing formation _____ Depth to top _____ Bottom _____ Total Depth of Well 3506 Feet
Show depth and thickness of all water, oil and gas formations.

OIL, GAS OR WATER RECORDS

CASING RECORD

FORMATION	CONTENT	FROM	TO	SIZE	PUT IN	PULLED OUT
				8 5/8"	210'	none

Describe in detail the manner in which the well was plugged, indicating where the mud fluid was placed and the method or methods used in introducing it into the hole. If cement or other plugs were used, state the character of same and depth placed, from _____ feet to _____ feet for each plug set.

Put solid bridge in bottom of surface pipe from 210 feet to 195 feet then spotted 3 cubic yards ready mix cement to surface also put 500 lbs ready mix cement in rathole.

RECEIVED
STATE CORPORATION COMMISSION

JUL 18 1962

CONSERVATION DIVISION
Wichita

7-18-62

(If additional description is necessary, use BACK of this sheet)

Name of Plugging Contractor Donald T. Ingling
Address 615 First National Bldg., Wichita 2, Kansas

STATE OF KANSAS, COUNTY OF SEDGWICK, ss.
D. T. Ingling (employee of owner) or (owner or operator) of the above-described well, being first duly sworn on oath, says: That I have knowledge of the facts, statements, and matters herein contained and the log of the above-described well as filed and that the same are true and correct. So help me God.

(Signature) [Signature]
615 First National Bldg., Wichita 2
(Address)

SUBSCRIBED AND SWORN TO before me this 17th day of July, 19 62

My commission expires Feb. 27, 1964

Notary Public.

INVOICED

DATE 9/18/62

INV. NO. 5389-w

WELL LOG - RICHERT NO. 1

Donald T. Ingling et al, Lease Owner

Section 10-21-1W

Donald T. Ingling, Contractor

Location: C NE NE SE

Commenced: 7-3-62

County: McPherson

Completed: 7-15-62

Production: dry

Total Depth: 3506 (rotary)

Elevation: 1526 RB

Casing: 8 5/8" 210' (125 sacks cement)

Figures below indicate bottom formation

75	sand and shale	3030	Mississippi
210	shale and shells	3097	Mississippi - lime and chert
350	shale and shells	3130	lime and chert
490	lime, shale and sand	3170	lime and chert
570	shale and shells	3203	lime and chert
740	lime w/shale streaks	3215	chert and lime
880	lime and shale streaks	3250	lime
1195	shale, lime and sand	3286	lime
1500	shale, shells and lime streaks	3325	shale
1515	lime	3408	shale and lime
1560	shale and shells	3432	shale
1570	lime	3460	Conglomerate and shale
1800	shale and lime streaks	3483	shale
2000	shale and lime	3506	Viola
2007	shale	3506	Total Depth
2052	lime and shale		
2080	lime		
2100	shale and lime		
2148	shale and lime		
2298	shale and sand		
2330	lime and shale		
2450	lime and shale		
2527	lime		
2590	lime		
2685	lime and shale		
2689	lime		
2700	shale		
2724	lime		
2754	shale and lime		
2850	shale and lime		
2932	shale and lime		
2972	Conglomerate		
2994	lime - Mississippi		

RECEIVED
STATE CORPORATION COMMISSION

JUL 1 1962

CONSERVATION DIVISION
Wichita, Kansas

I certify this is a true and correct copy of the above mentioned well.

STATE OF KANSAS)
) ss.
SEDGWICK COUNTY)

D. T. Ingling

Subscribed and sworn to before me, a Notary Public, in said county and state.

My commission expires: 2-27-64

McClade
Notary Public