

STATE OF KANSAS  
STATE CORPORATION COMMISSION

WELL PLUGGING RECORD

Give All Information Completely  
Make Required Affidavit  
Mail or Deliver Report to:  
Conservation Division  
State Corporation Commission  
212 No. Market  
Wichita, Kansas

McPherson County, Sec. 9 Twp. 21 Rge. 1 (E) X (W)

Location as "NE/CNW/SW" or footage from lines. SE SE NW

Lease Owner J. M. Siegel

Lease Name Fischer Well No. 1

Office Address Wichita, Kansas

Character of Well (completed as Oil, Gas or Dry Hole) Dry Hole

Date well completed 7-26, 1966

Application for plugging filed 7-26, 1966

Application for plugging approved 7-26, 1966


Plugging commenced 7-26, 1966

Plugging completed 7-26, 1966

Reason for abandonment of well or producing formation \_\_\_\_\_

If a producing well is abandoned, date of last production \_\_\_\_\_ 19\_\_\_\_

Was permission obtained from the Conservation Division or its agents before plugging was commenced? Yes

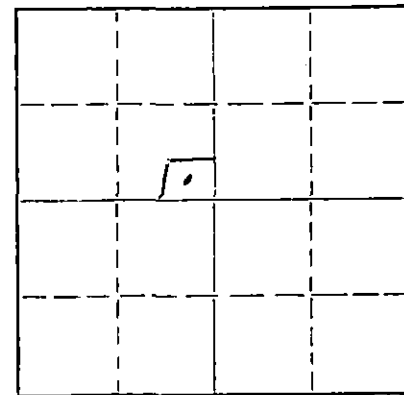

Locate well correctly on above  
Section Plat

Name of Conservation Agent who supervised plugging of this well Hugh Scott

Producing formation \_\_\_\_\_ Depth to top \_\_\_\_\_ Bottom \_\_\_\_\_ Total Depth of Well 3400 Feet

Show depth and thickness of all water, oil and gas formations.

OIL, GAS OR WATER RECORDS

CASING RECORD

FORMATION	CONTENT	FROM	TO	SIZE	PUT IN	PULLED OUT
				8 5/8	208	None

Describe in detail the manner in which the well was plugged, indicating where the mud fluid was placed and the method or methods used in introducing it into the hole. If cement or other plugs were used, state the character of same and depth placed, from \_\_\_\_\_ feet to \_\_\_\_\_ feet for each plug set.

Filled hole with mud to 200'  
Set bridge on mud  
Dumped 25 sacks of cement on bridge  
Filled hole with mud to 30'  
Set plug on mud  
Filled to surface with cement  
Plugged rat hole with 2 sacks  
Plugging completed.

RECEIVED  
STATE CORPORATION COMMISSION  
AUG 1 1966

CONSERVATION DIVISION  
Wichita, Kansas

(If additional description is necessary, use BACK of this sheet)

Name of Plugging Contractor Slusser Drilling Company

Address Box 275, Marion, Kansas 66861

STATE OF Kansas, COUNTY OF Marion, ss.

Billy H. Slusser (employee of owner) or (owner or operator) of the above-described

well, being first duly sworn on oath, says: That I have knowledge of the facts, statements, and matters herein contained and the log of the above-described well as filed and that the same are true and correct. So help me God.

(Signature) Billy H. Slusser

Box 275, Marion, Kansas 66861  
(Address)

SUBSCRIBED AND SWORN to before me this 26th day of July, 1966

My commission expires July 6, 1967

Revised - 2. Mott Conyers  
(Mrs.) Vivian I. Mott Conyers Notary Public.

## DRILLERS LOG

Company  
Contractor  
Farm  
8 5/8

J. M. Siegel  
Slusser Drilling Co.  
Fischer #1  
@ 208


Commenced 7-19-66  
Completed 7-26-66  
SE SE NW 9-21-1W  
McPherson Co., Kansas

Surface Soil	5
Sand	35
Shale	420
Shale & Lime	530
Lime & Shale	1170
Shale & Lime	1525
Lime & Shale	2150
Shale & Lime	2203
Sand & Shale	2256
Lime	2400
Shale & Lime	2520
Lime	2620
Shale & Lime	2922
Chat	3010
Lime	3206
Shale	3400 Rotary T. D.

RECEIVED  
STATE CORPORATION COMMISSION  
JUL 27 1966  
CONSERVATION DIVISION  
WICHITA, KANSAS

-----

I, Billy H. Slusser, certify the above to be a true and correct copy of the Driller's Log of the said well, according to the records of this office.

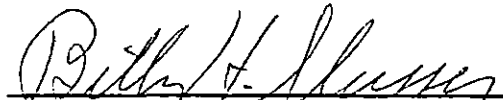  
Billy H. Slusser, Partner

SLUSSER DRILLING COMPANY