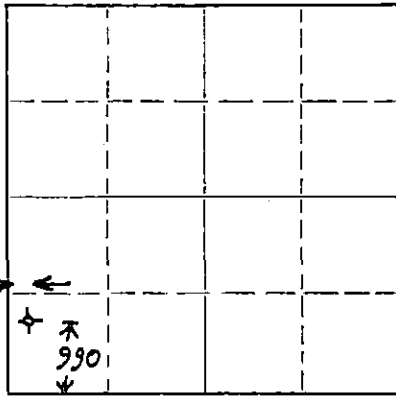


Give All Information Completely
Make Required Affidavit
Mail or Deliver Report to:
Conservation Division
State Corporation Commission
211 No. Broadway
Wichita, Kansas

WELL PLUGGING RECORD

NORTH

Locate well correctly on above
Section Plat

Stafford County, Sec. 21 Twp. 23S Rge. 14W (E) (W) X

Location as "NE/CNW/SW" or footage from lines 300' W L 990 S L

Lease Owner Roach & Lichty Drilling, Inc.

Lease Name Snyder Well No. 1

Office Address 505 Union National Bank Building, Wichita, Kansas

Character of Well (completed as Oil, Gas or Dry Hole) Dry Hole

Date well completed October 4, 19 56

Application for plugging filed October 4, 19 56

Application for plugging approved October 4, 19 56

Plugging commenced October 4, 19 56

Plugging completed October 4, 19 56

Reason for abandonment of well or producing formation Dry

If a producing well is abandoned, date of last production 19

Was permission obtained from the Conservation Division or its agents before plugging was commenced? Yes

Name of Conservation Agent who supervised plugging of this well Mr. R. M. Brundage

Producing formation Depth to top Bottom Total Depth of Well 4094 Feet

Show depth and thickness of all water, oil and gas formations.

OIL, GAS OR WATER RECORDS

CASING RECORD

FORMATION	CONTENT	FROM	TO	SIZE	PUT IN	PULLED OUT

Describe in detail the manner in which the well was plugged, indicating where the mud fluid was placed and the method or methods used in introducing it into the hole. If cement or other plugs were used, state the character of same and depth placed, from feet to feet for each plug set.

Heavy drilling mud to 180 feet. Drove plug to 180 feet added 20 sacks of cement. Second plug drove to 40 feet added 10 sacks of cement.

The plugging was done through the drill pipe by hand.

10-10-56

GOVERNMENT
WICHITA

(If additional description is necessary, use BACK of this sheet)

Name of Plugging Contractor Mr. C. P. Wilson

Address Box 12, Pratt, Kansas

STATE OF Kansas, COUNTY OF Sedgwick, ss.

Clark A. Roach (employee of owner) or (owner or operator) of the above-described well, being first duly sworn on oath, says: That I have knowledge of the facts, statements, and matters herein contained and the log of the above-described well as filed and that the same are true and correct. So help me God.

(Signature)

Clark A. Roach

505 Union National Bank Building, Wichita, Kans.
(Address)

SUBSCRIBED AND SWORN TO before me this 9th day of October, 19 56

Verdina B. Rutledge

Verdina B. Rutledge

Notary Public.

My commission expires March 15, 1960

PLUGGING
FILE SEC. 21 T. 22 R. 14
BOOK PAGE 104 LINE 42

CONTRACTOR'S WELL LOG

15-185-00913-0000

COMPANY:
CONTRACTOR:
FARM:
LOCATION:

Roach & Lichty Drilling, Inc.
Roach & Lichty Drilling, Inc.
SNYDER #1
NW SW SW Sec. 21-23S-14W
Stafford County, Kansas
September 17, 1956
October 3, 1956

COMMENCED:
COMPLETED:

0	70	sand & gravel
70	110	clay & sand
110	155	sand
155	230	blue shale
230	245	sand & shale
245	330	red bed & shale
330	385	sand
385	400	shale
400	865	red bed & shale
865	890	anhydrate
890	1675	shale & shells
1675	2110	shale & lime
2110	2177	lime
2177	3225	shale & lime
3225	3305	lime
3305	3592	shale & lime
3592	3825	lime
3825	3971	shale & lime
3971	3991	lime & chert
3991	3994	shale
3994	4015	lime, shale, & chert
4015	4023	shale & sand
4023	4038	Arbuckle
4038	4090	lime, shale, & chert
4090	4094	Dolomite
	4094	Rotary Total Depth

Set 8-5/8" surface at 191' with 200 sacks Posmix, 2% Calcium chloride.

ELEVATION:	1961'	Derrick Floor	Base K. C.	3827'	(-1864)
	1963'	Kelly Bushing	Cong. Shale	3889'	(-1926)
TOPS: HEEBNER	3432'	(-1469)	Mississippi	3919'	(-1956)
Toronto	3451'	(-1488)	Chert. Vio.	3951'	(-1988)
BrownLime	3568'	(-1605)	Simp. Shale	3994'	(-2031)
Lans. K.C.	3578'	(-1615)	Simp. Sand	4007'	(-2044)
Arbuckle	4047'	(-2084)	Rotary T.D.	4094'	(-2131)

PLUGGING

FILE SEC 21 T. 23 S. 14
BOOK PAGE 104 LINE 42

STATE OF KANSAS)
) SS
COUNTY OF SEDGWICK)

I, Clark A. Roach, do hereby certify that the above and foregoing is a true and correct copy of the log of the SNYDER #1, NW SW SW, Section 21-23S-14W, Stafford County, Kansas, as reflected by the files of the Roach & Lichty Drilling, Inc.

ROACH & LICHTY DRILLING, INC.

BY Clark A. Roach
President

Subscribed and sworn to before me, a Notary Public, in and for Sedgwick County, Kansas, this 9th day of October, 1956.

Verdina B. Rutledge
Notary Public

My commission expires March 15, 1960.

PLUGGING			
FILE	SEC	T	R
BOOK	PAGE	LINE	