

15-185-00958-0000

STATE OF KANSAS
STATE CORPORATION COMMISSION


Form CP-4

WELL PLUGGING RECORD

Give All Information Completely
Make Required Affidavit
Mail or Deliver Report to:
Conservation Division
State Corporation Commission
211 No. Broadway
Wichita, Kansas

Stafford County. Sec. 21 Twp. 23S Rge. 14 /W/ (W)
Location as "NE/CNW%SW%" or footage from lines SE NE SE
Lease Owner Pickrell Drilling Co.
Lease Name Birdsall Well No. 1
Office Address 705 4th Nat'l Bank Bldg., Wichita 2,
Character of Well (completed as Oil, Gas or Dry Hole) oil
Date well completed 10-10-53 19
Application for plugging filed 9-26-63 19
Application for plugging approved 9-28-63 19
Plugging commenced 10-01-63 19
Plugging completed 10-05-63 19
Reason for abandonment of well or producing formation depleted

NORTH

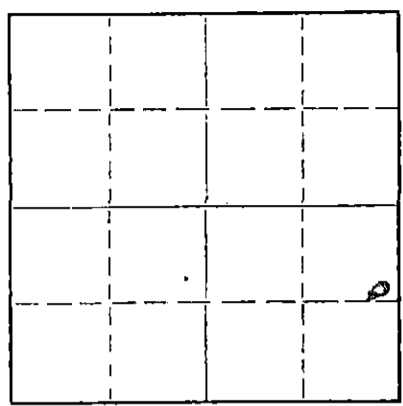

Locate well correctly on above
Section Plat

If a producing well is abandoned, date of last production _____ 19
Was permission obtained from the Conservation Division or its agents before plugging was commenced? yes

Name of Conservation Agent who supervised plugging of this well Archie Elving
Producing formation _____ Depth to top _____ Bottom _____ Total Depth of Well 4075 Feet
Show depth and thickness of all water, oil and gas formations. Plugged back 3740

OIL, GAS OR WATER RECORDS

CASING RECORD

FORMATION	CONTENT	FROM	TO	SIZE	PUT IN	PULLED OUT
				8 5/8	210'	circulated
				5 1/2	3770	2602.37

Describe in detail the manner in which the well was plugged, indicating where the mud fluid was placed and the method or methods used in introducing it into the hole. If cement or other plugs were used, state the character of same and depth placed, from _____ feet to _____ feet for each plug set.

At 3590 feet, set 5 foot rock bridge and dumped 5 sacks cement. With pump truck, pumped 15 sacks mud, put in plug and pump 75 sacks cement at 100 P.S.I.

RECEIVED
STATE CORPORATION COMMISSION

OCT 10 1963

CONSERVATION DIVISION
Wichita, Kansas

(If additional description is necessary, use BACK of this sheet)

Name of Plugging Contractor Kent Well Servicing Co.
Address Box 470, El Dorado, Kansas

STATE OF Kansas, COUNTY OF Butler, ss.

(employee of owner) or (owner or operator) of the above-described well, being first duly sworn on oath, says: That I have knowledge of the facts, statements, and matters herein contained and the log of the above-described well as filed and that the same are true and correct. So help me God.

(Signature) Mary Wayne

(Address)

SUBSCRIBED AND SWORN TO before me this 9th day of October, 19 63

My commission expires June 18 1967

Edmund S. Phillips
Notary Public.

WELL LOG

Company: GREENLAND DRILLING CO.

Sec. 21 T 23S R 14W
Loc. SE NE SE
Stafford Co., Kansas

Well: BIRDSALL No. 1

15-185-00958-0000

Total Depth: 4075
Commenced: 9-23-53
Completed: 10-10-53
Contractor: Greenland Drilling Company

Casing: 8-5/8" 210'
5-1/2" 3770'

Elevation: 1942 DF
Frods

Figures Indicate Bottom of Formations

140	Sand w/clay streaks	TOPS:	
210	Shale & shells	Anhydrite	852
315	Shale & shells	Kansas City	3564
375	Sand	Viola	3883
735	Red bed w/sand streaks	Arbuckle	4044
852	Sand and red bed	TDR	4075
875	Anhydrite		
1345	Shale & shells and salt		
1510	Shale & shells		
1585	Shale & lime		
1725	Lime and shale		
1970	Lime & shale		
2075	Lime w/shale breaks		
2275	Lime & shale		
2450	Shale & lime		
2620	Sandy shale & lime		
2695	Shale & lime		
2870	Lime and shale		
3020	Shale & lime		
3057	Lime		
3135	Lime & shale		
3320	Lime w/shale breaks		
3393	Lime & shale		
3443	Lime		
3482	Shale		
3485	Lime		
3492	Shale w/sand streaks		
3554	Shale & sandy shale		
3560	Green lime		
3564	Shale		
3573	Lime		
3613	Lime & shale		
3815	Lime		
3807	Shale & lime		
3923	Viola quartz & lime		
3969	Green lime & shale		
3982	Chert		
3990	Chert lime		
4000	Stagnant chert		
4042	Shale & sand		
4043	Lime		
4046	Lime & shale		
4075	Arbuckle		
4075	T.D.		

RECEIVED
STATE CORPORATION COMMISSION

OCT 11 1953

CONSERVATION DIVISION
Wichita, Kansas

STATE OF KANSAS, COUNTY OF SEDGWICK, ss.

I, Richard S. Davis, of the Greenland Drilling Company, upon oath, state that the above and foregoing is a true and correct copy of the #1 Birdsall well.

Richard S. Davis
Richard S. Davis, Vice-President

Subscribed and sworn to before me
this 22nd day of November, 1955.

My commission expires March 15, 1956.

Verdine L. Colledge
Verdine L. Colledge, Notary Public