

STATE OF KANSAS
STATE CORPORATION COMMISSION

WELL PLUGGING RECORD

Give All Information Completely
Make Required Affidavit
Mail or Deliver Report to:
Conservation Division
State Corporation Commission
211 No. Broadway
Wichita, Kansas

Rice County. Sec. 11 Twp. 21 Rge. (E) 10 (W)

Location as "NE/CNWxSWx" or footage from lines SW SW SW

Lease Owner Donald T. Ingling et al

Lease Name Fair Well No. 1

Office Address 623 1st Nat'l Bank Bldg., Wichita 2

Character of Well (completed as Oil, Gas or Dry Hole) Dry Hole

Date well completed December 15, 1957

Application for plugging filed December 11, 1957

Application for plugging approved December 11, 1957


Plugging commenced December 11, 1957

Plugging completed December 11, 1957

Reason for abandonment of well or producing formation Dry

If a producing well is abandoned, date of last production 19

Was permission obtained from the Conservation Division or its agents before plugging was commenced? Yes

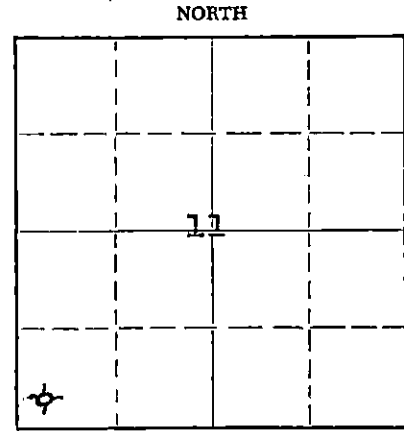

Locate well correctly on above Section Plat

Name of Conservation Agent who supervised plugging of this well Ruel Durkee

Producing formation Depth to top Bottom Total Depth of Well 3142 Feet

Show depth and thickness of all water, oil and gas formations.

OIL, GAS OR WATER RECORDS

CASING RECORD

FORMATION	CONTENT	FROM	TO	SIZE	PUT IN	PULLED OUT
				8 5/8"	249'	None

Describe in detail the manner in which the well was plugged, indicating where the mud fluid was placed and the method or methods used in introducing it into the hole. If cement or other plugs were used, state the character of same and depth placed, from feet to feet for each plug set.

Gunned pits one hour, layed down one-half drill pipe, circulated one-half hour and layed down balance of drill pipe - put plug at 230 ft solid then 15 sacks cement through 7 joints of drill pipe - filled hole to within 15 ft of ground level and capped with 5 sacks of cement. Plugging completed.

RECEIVED
STATE CORPORATION COMMISSION
DEC 23 1957
12-23-57
CONSERVATION DIVISION
Wichita, Kansas

Name of Plugging Contractor Donald T. Ingling

Address 623 1st Nat'l Bank Bldg., Wichita 2

STATE OF KANSAS, COUNTY OF SEDGWICK, ss.
D. T. Ingling (employee of owner) or (owner or operator) of the above-described

well, being first duly sworn on oath, says: That I have knowledge of the facts, statements, and matters herein contained and the log of the above-described well as filed and that the same are true and correct. So help me God.

(Signature) D. T. Ingling

623 1st Nat'l Bank Bldg., Wichita 2 (Address)

SUBSCRIBED AND SWORN to before me this 20th day of December, 1957

ME Black

Notary Public.

My commission expires Feb. 27, 1960

PLUGGING
FILE SEC 11 T 21 R 10 W
BOOK PAGE 70 LINE 36

WELL LOG - FAIR NO. 1

Donald T. Ingling et al, Lease Owner

Section 11-21-10W

Donald T. Ingling, Contractor

Location: SW SW SW

Commenced: 12-6-57
Completed: 12-15-57

County: Rice

Total Depth: 3442'

Production: Dry

Casing: 8 5/8" 249' (175 sacks cement)

Elevation: 1711 RB

Figures below indicate bottom formation

85	sand	3000	sand and shale
190	red shale	3095	lime - Lansing
249	shale and shells	3139	lime
350	shale, shells and red rock	3220	lime
370	Anhydrite	3285	lime
510	shale, shells and red rock	3314	lime
1175	shale, shells and red rock	3337	Conglomerate
1240	shale and lime	3385	shale - Simpson
1500	lime and shale	3397	shale
1565	lime and shale	3442	lime - Arbuckle
1670	lime	3442	Total Depth
1835	lime		
2000	lime and shale		
2250	shale and lime streaks		
2420	lime and shale		
2480	lime		
2555	shale		
2665	lime and shale		
2770	lime		
2820	lime		
2840	lime		
2870	shale		
2903	shale and lime		

I certify this is a true and correct copy of the above mentioned well.

D. Ingling

STATE OF KANSAS)
) SS:
SEDGWICK COUNTY)

Subscribed and sworn to before me, a Notary Public, in said county and state.

M. E. Black
Notary Public

RECORDED
STATE CORPORATION COMMISSION

My commission expires: Feb. 27, 1960

DEC 23 1957

CONSERVATION DIVISION
Wichita, Kansas

PLUGGING
FILE SEC 11 T. 21 R. 106
BOOK PAGE 70 LINE 36