


STATE OF KANSAS
STATE CORPORATION COMMISSION

WELL PLUGGING RECORD

Give All Information Completely
Make Required Affidavit
Mail or Deliver Report to:
Conservation Division
State Corporation Commission
800 Bittling Building
Wichita, Kansas

Rice County, Sec. 14 Twp. 21 Rge. 10 (E)E (W)W
Location as "NE/CNW%SW%" or footage from lines NE NW SW
Lease Owner North American Petroleum Co.
Lease Name Fair Well No. 1
Office Address #1 La Salle St., Chicago, Illinois
Character of Well (completed as Oil, Gas or Dry Hole) Dry Hole
Date well completed 10-27-54 19
Application for plugging filed 10-27-54 19
Application for plugging approved 10-27-54 19
Plugging commenced 10-28-54 19
Plugging completed 10-28-54 19
Reason for abandonment of well or producing formation Dry

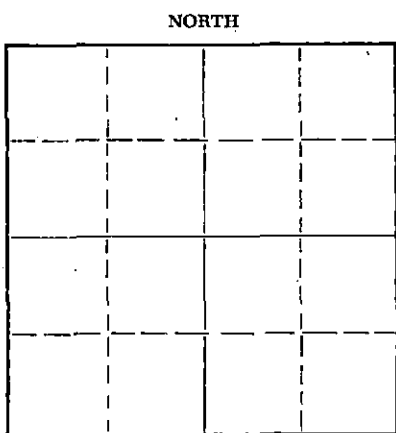

Locate well correctly on above
Section Plat

If a producing well is abandoned, date of last production 19
Was permission obtained from the Conservation Division or its agents before plugging was commenced? Yes

Name of Conservation Agent who supervised plugging of this well Warren Horner
Producing formation None Depth to top Bottom Total Depth of Well 3455 Feet
Show depth and thickness of all water, oil and gas formations.

OIL, GAS OR WATER RECORDS

CASING RECORD

FORMATION	CONTENT	FROM	TO	SIZE	PUT IN	PULLED OUT

Describe in detail the manner in which the well was plugged, indicating where the mud fluid was placed and the method or methods used in introducing it into the hole. If cement or other plugs were used, state the character of same and depth placed, from feet to feet for each plug set.

Filled hole with heavy drilling mud from 3455' to 250'. Set 1/3 sack of hulls and plug @ 250'. 20 sacks of cement and mud to 35', 1/3 sack of hulls and plug @ 35' with 10 sacks cement to bottom of cellar.

(If additional description is necessary, use BACK of this sheet)

Name of Plugging Contractor Capitt Drilling
Address 1005 Central Bldg. Wichita, Kansas

STATE OF _____, COUNTY OF _____, ss. agent
L. J. Clampitt (Employed by owner) or (owner or operator) of the above-described well, being first duly sworn on oath, says: That I have knowledge of the facts, statements, and matters herein contained and the log of the above-described well as filed and that the same are true and correct. So help me God.

(Signature) *L. J. Clampitt*
(Address)

SUBSCRIBED AND SWORN TO before me this 8th day of November, 1954

Frances Marder
Notary Public.

My commission expires June 25, 1956

PLUGGING
FILE SEC. 14 TWP. 21 RGE. 10W
BOOK PAGE 23 LINE 41

11-9-54
CONSERVATION DIVISION
Wichita, Kansas

ROTARY DRILLING LOG

OPERATOR: North American Petroleum Co.
 Fair #1
 NE NW SW Sec. 14-21S-10W
 Rice County, Kansas

CONTRACTOR: Capitt Drilling, Inc.
 Comm: 10-14-54
 Comp: 10-27-54

FORMATION

REMARKS

Sand	95
Lime Shells, Red Bed Shale	215
Shale & Shells	252
Red Bed Shale	500
Shale & Shells	990
Shale & Lime	1120
Lime	1280
Shale & Lime	1390
Shale & Lime	1450
Lime & Shale	1570
Lime	1740
Lime & Shale	1975
Lime & Shale Breaks	2030
Shale & Lime	2105
Shale	2125
Shale & Lime	2360
Shale & Lime	2460
Lime	2505
Shale	2538
Sand	2560
Shale & Lime (Sandy)	2580
Lime & Shale Breaks	2615
Lime	2670
Lime & Shale	2710
Lime	2750
Lime & Shale	2775
Lime & Shale Breaks	2845
Shale & Lime	2970
Lime	2975
Lime & Shale	3005
Lime (Lansing)	3040
Lime	3073
Lime	3332
Conglomerate & Chert	3345
Simpson	3348
Lime Sand & Shale	3395
Shale & Lime	3410
Lime	3420
Lime	3455
Rotary total depth	3455

Ran 252' 8-5/8" Casing
 Cemented with 150 sks. posmix.

We certify that the above log is true and correct to the best of our knowledge and ability.

CAPITT DRILLING, INC.

By: R.R. McNeal

RECEIVED
 OCT 28 1954
 CONSERVATION
 DIVISION

PLUGGING
 FILE SEC 14-21 R 10W
 BOOK PAGE 23 LINE 41