

STATE OF KANSAS
STATE CORPORATION COMMISSION


15-145-20562-0000

WELL PLUGGING RECORD

Give All Information Completely
Make Required Affidavit
Mail or Deliver Report to
Conservation Division
State Corporation Comm.
245 North Water
Wichita, KS 67202

Pawnee County. Sec. 4 Twp. 23S Rge. 15W E/W
Location as "NE/CNW $\frac{1}{4}$ SW $\frac{1}{4}$ " or footage from lines
NW NE SE

Lease Owner Zenith Drilling Corporation, Inc.
Lease Name Blodgett #1 Well No. 1
Office Address Suite 600, 200 West Douglas, Wichita, Ks 67202
Character of Well (Completed as Oil, Gas or Dry Hole)

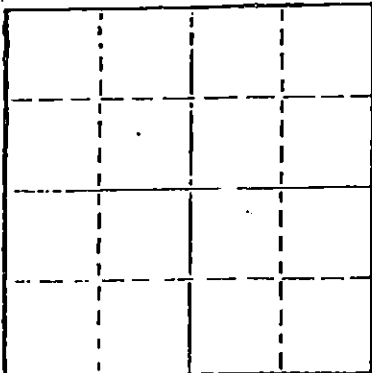

Locate well correctly on above
Section Plot

Dry Hole
Date Well completed December 23, 1978 19
Application for plugging filed December 22, 1978 19
Application for plugging approved December 22, 1978 19
Plugging commenced 7:00 AM, December 23, 1978 19
Plugging completed 8:30 AM, December 23, 1978 19
Reason for abandonment of well or producing formation

Dry Hole
If a producing well is abandoned, date of last production 19

Was permission obtained from the Conservation Division or
its agents before plugging was commenced? Yes

Name of Conservation Agent who supervised plugging of this well Leo Massey
Producing formation Depth to top Bottom Total Depth of Well 4045'
Show depth and thickness of all water, oil and gas formations.

OIL, GAS OR WATER RECORDS

CASING RECORD

FORMATION	CONTENT	FROM	TO	SIZE	PUT IN	PULLED OUT
				8 5/8"	251'	None

Describe in detail the manner in which the well was plugged, indicating where the mud fluid
was placed and the method or methods used in introducing it into the hold. If cement or other
plugs were used, state the character of same and depth placed, from _____ feet to
_____ feet for each plug set.

Filled hole with heavy mud.
50 sacks 50/50 Pozmix at 420';
25 sacks at 240' and 10 sacks at
40'.

2-21-79

RECEIVED
STATE CORPORATION COMMISSION
FEB 21 1979
CONSERVATION DIVISION
Wichita, Kansas

(If additional description is necessary, use BACK of this sheet)

Name of Plugging Contractor STERLING DRILLING COMPANY

STATE OF KANSAS COUNTY OF RICE, ss.
Bernard Laudermilk (employee of owner) or (owner or operator)

of the above-described well, being first duly sworn on oath, says: That I have knowledge of
the facts, statements, and matters herein contained and the log of the above-described well
as filed and that the same are true and correct. So help me God.

(Signature) Bernard Laudermilk
Bernard Laudermilk, President
P. O. Box 129, Sterling, Kansas 67579
(Address)

SUBSCRIBED AND SWORN TO before me this 26th day of December, 1978.

Charles M. Hall, Notary Public.

My commission expires



STERLING DRILLING COMPANY
P. O. Box 129
Sterling, Kansas 67579

15-145-20562-0000

WELL LOG ----- BLODGETT #1
Located: NW NE SE, Section 4-23S-15W, Pawnee County, Kansas

OWNER: Zenith Drilling Corporation, Inc.
ROTARY DRILLING CONTRACTOR: Sterling Drilling Company

COMMENCED: December 13, 1978
COMPLETED: December 23, 1978

TOTAL DEPTH: 4045'

<u>LOG</u>	
0 - 100	Clay and Sand
100 - 256	Clay and Shale
256 - 291	Shale
291 - 971	Anhydrite
971 - 1590	Shale
1590 - 1930	Shale and Lime Str.
1920 - 4045	Lime and Shale

CASING RECORD

Ran 6 joints new 23#, 8 5/8" casing,
241.47' set at 254' K.B. with 225 sacks
60/40 Pozmix with 3% cc. Plug down at
2:15 PM, 12-13-78, by Sun.

Plugged

RECEIVED
STATE CORPORATION COMMISSION

FEB 21 1979

CONSERVATION DIVISION
Wichita, Kansas