


STATE OF KANSAS  
STATE CORPORATION COMMISSION

Give All Information Completely  
Make Required Affidavit  
Mail or Deliver Report to:  
Conservation Division  
State Corporation Commission  
P. O. Box 17027  
Wichita, Kansas 67217  
NORTH

15-145-30178-0007

WELL PLUGGING RECORD

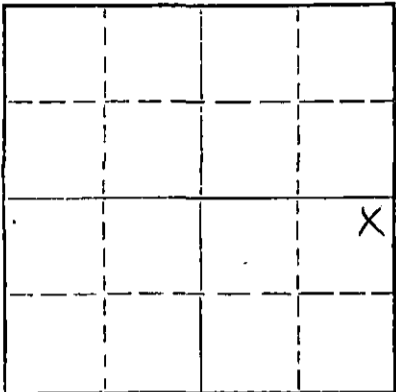

Locate well correctly on above Section Plat

Pawnee County, Sec. 4 Twp. 23S Rge. 15 (E) W (W)  
Location as "NE/CNW/SW" or footage from lines NE/4 NE/4 SE/4  
Lease Owner Robert F. White  
Lease Name Fox-Blodgett Well No. # 1  
Office Address 714 Union Center ; Wichita, Ks. 67202  
Character of Well (completed as Oil, Gas or Dry Hole) Gas  
Date well completed May 28 1969  
Application for plugging filed July 12 1972  
Application for plugging approved July 1972  
Plugging commenced July 12 1972  
Plugging completed August 1 1972  
Reason for abandonment of well or producing formation No longer economic.

If a producing well is abandoned, date of last production July 1971  
Was permission obtained from the Conservation Division or its agents before plugging was commenced? Yes

Name of Conservation Agent who supervised plugging of this well Leo Massey  
Producing formation Howard Lime Depth to top 2984' Bottom 3000' Total Depth of Well 3055' Feet  
Show depth and thickness of all water, oil and gas formations.

OIL, GAS OR WATER RECORDS

CASING RECORD

FORMATION	CONTENT	FROM	TO	SIZE	PUT IN	PULLED OUT
Surface Casing	8 5/8"	0	250'	8 5/8"	250'	None
Production String	5 1/2"	0	3055'	5 1/2"	3055'	2202'

Describe in detail the manner in which the well was plugged, indicating where the mud fluid was placed and the method or methods used in introducing it into the hole. If cement or other plugs were used, state the character of same and depth placed, from \_\_\_\_\_ feet to \_\_\_\_\_ feet for each plug set.

July 12, 1972 Dumped sand to 2850'. Mixed and dumped 5 sx of cement.  
August 1, 1972 Plugged off top. Allied Cementing Co. mixed and pumped down 8 5/8" surface casing, 3 sx of hulls, 20 sx of gel and 100 sx + 6% gel cement.


RECEIVED  
STATE CORPORATION COMMISSION  
AUG 10 1972  
CONSERVATION DIVISION  
Wichita, Kansas

(If additional description is necessary, use BACK of this sheet)  
Name of Plugging Contractor RUSS CASING PYLLING, INC.  
Address P. O. Box 1082 ; Great Bend, Kansas 67530

STATE OF KANSAS, COUNTY OF SEDGWICK, ss.  
Robert F. White, Employee or owner of (owner or operator) of the above-described well, being first duly sworn on oath, says: That I have knowledge of the facts, statements, and matters herein contained and the log of the above-described well as filed and that the same are true and correct. So help me God.

(Signature) [Signature]  
714 Union Center, Wichita, Kansas 67202  
(Address)

Subscribed and sworn to before me this 9th day of August, 1972

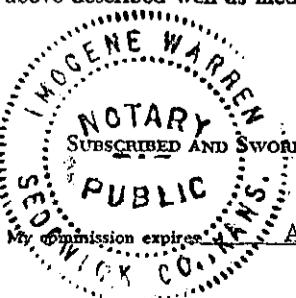

[Signature]  
Imogene Warren Notary Public.

My commission expires August 6, 1975