

STATE OF KANSAS
STATE CORPORATION COMMISSION


WELL PLUGGING RECORD

15-145-20945-0000

Give All Information Completely
Make Required Affidavit
Mail or Deliver Report to
Conservation Division
State Corporation Comm.
245 North Water
Wichita, KS 67202

Pawnee County, Sec. 6 Twp. 23 Rge. 15 E/W
Location as "NE/CNW $\frac{1}{2}$ /SW $\frac{1}{2}$ " or footage from lines
NW NE NE

Lease Owner A. L. Abercrombie, Inc.
Lease Name Zook Well No. 1
Office Address 801 Union Center Wichita, KS 67202
Character of Well (Completed as Oil, Gas or Dry Hole)
Dry Hole

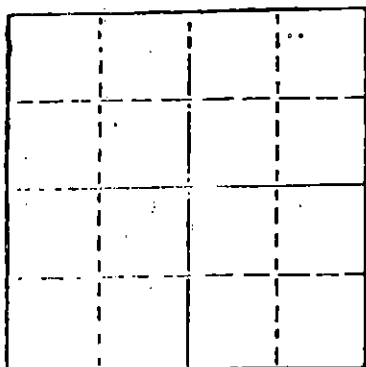

Locate well correctly on above
Section Plat

Date Well completed 4-21 1982
Application for plugging filed 4-26 1982
Application for plugging approved 5-12 1982
Plugging commenced 5-18 1982
Plugging completed 5-18 1982

Reason for abandonment of well or producing formation
Non-economical to produce
If a producing well is abandoned, date of last production 19

Was permission obtained from the Conservation Division or
its agents before plugging was commenced? Yes

Name of Conservation Agent who supervised plugging of this well Steve Durrant
Producing formation Viola & Mississippi Depth to top 3755' Bottom 3888' Total Depth of Well 4050'
Show depth and thickness of all water, oil and gas formations.

OIL, GAS OR WATER RECORDS

CASING RECORD

FORMATION	CONTENT	FROM	TO	SIZE	PUT IN	PULLED OUT
				8 5/8"	364	None
				4 1/2"	4048.77	None

Describe in detail the manner in which the well was plugged, indicating where the mud fluid was placed and the method or methods used in introducing it into the hold. If cement or other plugs were used, state the character of same and depth placed, from feet to feet for each plug set.

TD 4050' Plugged Zook #1 as follows:

- 75 sxs common
- 2 sxs hulls
- 10 sxs gel
- 1 sxs hull
- 10 sxs gel
- Release plug
- 70 sxs common w/ Sun Cementing Company

RECEIVED
STATE CORPORATION COMMISSION

5-18-82

Shut well in w/300# PSI standing. Plugging completed 11:30 a.m. 5-18-82

(If additional description is necessary, use BACK of this sheet)

Name of Plugging Contractor A. L. Abercrombie, Inc.

STATE OF Kansas COUNTY OF Barton, ss.
E. L. Abercrombie (employee of owner) or (owner or operator)
of the above-described well, being first duly sworn on oath, says: That I have knowledge of the facts, statements, and matters herein contained and the log of the above-described well as filed and that the same are true and correct. So help me God.


(Signature)

E L Abercrombie

Rt. #1 Box 56 Great Bend, KS 67530

(Address)

SUBSCRIBED AND SWORN TO before me this 18th day of May, 1982

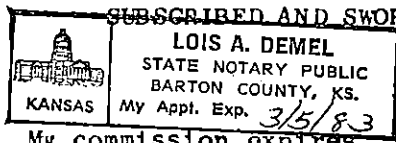

Lois A. Demel

Lois A. Demel

Notary Public.

My commission expires March 5, 1983