

15-145-28732-0000


STATE OF KANSAS
STATE CORPORATION COMMISSION

WELL PLUGGING RECORD

Give All Information Completely
Make Required Affidavit
Mail or Deliver Report to
Conservation Division
State Corporation Comm.
245 North Water
Wichita, KS 67202

Pawnee County, Sec. 16 Twp. 23S Rge. 15W
Location as "NE/CNW $\frac{1}{4}$ SW $\frac{1}{4}$ " or footage from lines
C W/2 NW

Lease Owner Alpine Drilling Co., Inc.
Lease Name E. Smith Well No. 1
Office Address 200 E. First, Suite 500, Wichita, KS 67202
Character of Well (Completed as Oil, Gas or Dry Hole)

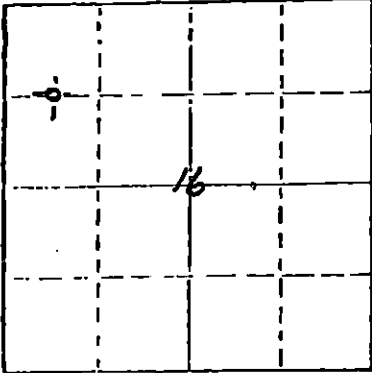

Locate well correctly on above
Section Plat

Dry Hole
Date Well completed December 5 19 80
Application for plugging filed December 5 19 80
Application for plugging approved December 5 19 80
Plugging commenced December 5 19 80
Plugging completed December 5 19 80
Reason for abandonment of well or producing formation

If a producing well is abandoned, date of last production 19

Was permission obtained from the Conservation Division or its agents before plugging was commenced? yes

Name of Conservation Agent who supervised plugging of this well Marion Schmidt
Producing formation Depth to top Bottom Total Depth of Well 4156
Show depth and thickness of all water, oil and gas formations.

OIL, GAS OR WATER RECORDS

CASING RECORD

FORMATION	CONTENT	FROM	TO	SIZE	PUT IN	PULLED OUT
surface hole	shale	surface	367	8-5/8	363'	none
	cemented with 250	sx common,	2%	gel, 3% cc,		
	plug down @ 2:45 p.m.	11-29-80	by Allied.			

Describe in detail the manner in which the well was plugged, indicating where the mud fluid was placed and the method or methods used in introducing it into the hold. If cement or other plugs were used, state the character of same and depth placed, from feet to feet for each plug set.

Plugged as follows:

plugged w/50-50 pozmix and 4% gel

70 sx at 600'

25 sx at 270'

bridge plug & sack hulls @ 40' & 10 sx of cement

5 sx in rat hole; Plug down at 1:30 p.m. 12-5-80 by Allied;

State Plugger; Marion Schmidt.

DEC 12 1980
CONSERVATION DIVISION
Wichita, Kansas

(If additional description is necessary, use BACK of this sheet.)

Name of Plugging Contractor Husky Drilling Co., Inc.

STATE OF KANSAS COUNTY OF Sedgwick, ss.

Jon T. Williams, Jr. (employee of owner) or (owner or operator)

of the above-described well, being first duly sworn on oath, says: That I have knowledge of the facts, statements, and matters herein contained and the log of the above-described well as filed and that the same are true and correct. So help me God.

(Signature)

200 E. First, Suite 500, Wichita, KS 67202

(Address)

SUBSCRIBED AND SWORN TO before me this 8th day of December, 1980

Geraldine Stewart
Geraldine Stewart Notary Public.

My commission expires January 12, 1981





200 East First, Suite 500
~~800 Biting Blvd~~
 Wichita, Kansas 67202
 Phone 316 - 263-7904
 Mobile Phone 316 - 793-7859 Unit 7070

15-145-20732-0000

December 8, 1980

WELL LOG-----E. Smith No. 1
 Located: C W/2 NW of Sec. 16-23S-15W, Pawnee Co., Kansas

OWNER: Alpine Drilling Co., Inc.
 ROTARY CONTRACTOR: Husky Drilling Co., Inc.


COMMENCED: November 29, 1980
 COMPLETED: December 5, 1980

Rotary Total Depth: 4156'

<u>LOG</u>		
0 -	120	Surface sand
120 -	220	Sand & shale
220 -	315	Shale
315 -	367	Red Bed
367 -	455	Red Bed & shale
455 -	520	Sand
520 -	987	Red Bed & shale
987 -	1012	Anhydrite
1012 -	1920	Shale & shells
1920 -	3936	Shale & lime
3936 -	4045	Lime
4045 -	4156	Lime & Shale

<u>CASING RECORD</u>
Ran 8 jts., used 24#, 8-5/8" casing, tallied 356.58 set @ 363' KB w/250 sx common, 2% gel, 3% cc, plug down @ 2:45 p.m. by Allied on 11-29-80.
Plugged & Abandoned 12-5-80.

I certify the above to be a true and correct copy of the driller's log to the best of my knowledge and belief.

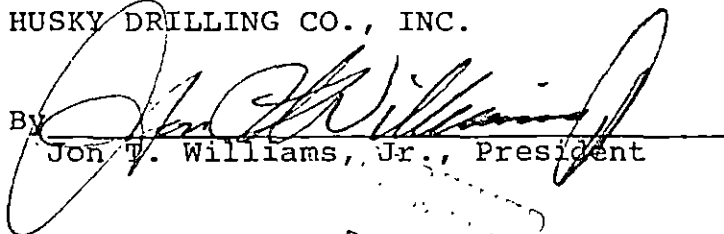HUSKY DRILLING CO., INC.
 BY 
 Jon T. Williams, Jr., President

DEC 12 1980
 CONSERVATION DIVISION
 Wichita, Kansas