


STATE OF KANSAS
STATE CORPORATION COMMISSION

Give All Information Completely
Make Required Affidavit
Mail or Deliver Report to:
Conservation Division
State Corporation Commission
211 No. Broadway
Wichita, Kansas

15.009.30897.00.00

WELL PLUGGING RECORD

NORTH

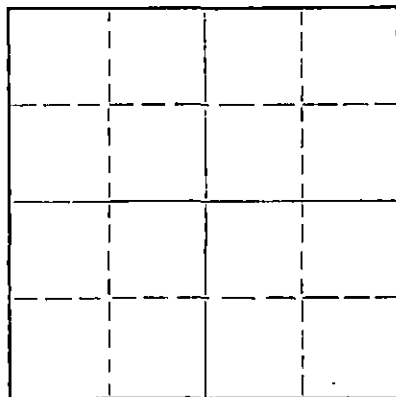

Locate well correctly on above
Section Plat

Barton County, Sec. 27 Twp. 20 Rge. 11 (B) (W)
Location as "NE/CNW/SW" or footage from lines NE NW NW
Lease Owner Ben C. W. Hyde, Jr.
Lease Name Hagen Well No. 1
Office Address 4722 Broadway Kansas City 12, Missouri
Character of Well (completed as Oil, Gas or Dry Hole) Dry Hole
Date well completed August 24, 1961 19 61
Application for plugging filed August 24 19 61
Application for plugging approved August 24, 19 61
Plugging commenced August 24, 19 61
Plugging completed August 24 19 61
Reason for abandonment of well or producing formation Dry hole

If a producing well is abandoned, date of last production _____ 19 ____
Was permission obtained from the Conservation Division or its agents before plugging was commenced? yes

Name of Conservation Agent who supervised plugging of this well Don Truan
Producing formation none Depth to top _____ Bottom _____ Total Depth of Well 3330 Feet
Show depth and thickness of all water, oil and gas formations.

OIL, GAS OR WATER RECORDS

CASING RECORD

FORMATION	CONTENT	FROM	TO	SIZE	PUT IN	PULLED OUT
				8 5/8" OD	212'	none

Describe in detail the manner in which the well was plugged, indicating where the mud fluid was placed and the method or methods used in introducing it into the hole. If cement or other plugs were used, state the character of same and depth placed, from _____ feet to _____ feet for each plug set.

Filled hole with heavy mud to 200 feet. Bridged hole and set plug at 200 feet run 20 sacks of cement 200' - up. Filled hole with mud for 35' Set plug at 35'. Ran 10 sacks of cement 35' to base of cellar.

Under direction of Don Truan.

RECEIVED
STATE CORPORATION COMMISSION

AUG 26 1961

CONSERVATION DIVISION
Wichita, Kansas

(If additional description is necessary, use BACK of this sheet)

Name of Plugging Contractor ISERN DRILLING COMPANY
Address Box 486 Ellinwood, Kansas

STATE OF KANSAS, COUNTY OF BARTON, ss.
M. M. Shopshire (employee of owner) or (owner or operator) of the above-described well, being first duly sworn on oath, says: That I have knowledge of the facts, statements, and matters herein contained and the log of the above-described well as filed and that the same are true and correct. So help me God.

(Signature) M. M. Shopshire
Ellinwood, Kansas
(Address)

SUBSCRIBED AND SWORN to before me this 24th day of August, 19 61

My commission expires July 7, 1965

Notary Public.

Ben. C. W. Hyde, Jr., HAGEN #1
NE NW NW Section 27-20-11
Barton County, Kansas

ELEVATION	1804' KB	Figures indicate bottom of formation:
		0 to 10 cellar
		125 sand
PIPE RECORD:		212 shale and shells
8 5/8" set at 212'		514 red bed
with 150 sacks cement		545 Anhydrite
		790 shale
Rotary Commenced: 8-15-61		1010 shale and shells
Completed 8-24-61		1260 salt
		1330 shale and shells
GEOLOGICAL TOPS:		2085 lime and shale
Heebner 2925		2655 shale and shells
Brown Lime 3047		3330 lime and shale
Lansing 3064		3330 Rotary Total Depth
Arbuckle 3325		
Total Depth 3330		

STATE OF KANSAS)
)ss
COUNTY OF BARTON)

I, M. M. SHROPSHIRE, Drilling Superintendent of the above-described well, being first duly sworn on oath, declare: That I have knowledge of the facts, statements and matter herein contained pertaining to the log of the above-described well, as filed, and that the same are true and correct.

M. M. Shopshire
M. M. Shopshire

RECEIVED
STATE CORPORATION COMMISSION

AUG 28 1961

Subscribed and sworn to before me this 24 day of August.

CONSERVATION DIVISION
Wichita, Kansas

I. J. Rader
I. J. Rader, Notary Public

My Commission expires July 7, 1964.