


WELL PLUGGING RECORD

Give All Information Completely
Make Required Affidavit
Mail or Deliver Report to:
Conservation Division
State Corporation Commission
212 No. Market
Wichita, Kansas

NORTH

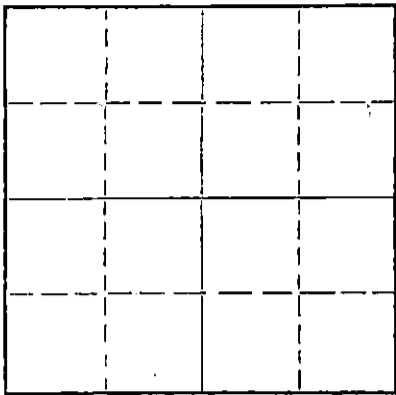

Locate well correctly on above
Section Plat

Barton County, Sec. 4 Twp. 19 Rge. (E) 15 (W)
Location as "NE/CNW/SW" or footage from lines SE NW NE
Lease Owner Charles L. Carlock
Lease Name Nordman Well No. 1
Office Address 1515 Hillcrest, Newton, Kansas
Character of Well (completed as Oil, Gas or Dry Hole) Dry hole.
Date well completed _____ 19____
Application for plugging filed _____ 19____
Application for plugging approved _____ 19____
Plugging commenced February 15, 19 68
Plugging completed February 21, 19 68
Reason for abandonment of well or producing formation no oil
O.W.W.D. D & A
If a producing well is abandoned, date of last production _____ 19____
Was permission obtained from the Conservation Division or its agents before plugging was commenced? Yes

Name of Conservation Agent who supervised plugging of this well Don Truan
Producing formation Lans. K.C. Depth to top 3298 Bottom 3302 Total Depth of Well PB 3310 feet
Show depth and thickness of all water, oil and gas formations.

OIL, GAS OR WATER RECORDS


CASING RECORD

FORMATION	CONTENT	FROM	TO	SIZE	PUT IN	PULLED OUT
Lans. K. C.	Dry	3298	3302	8 5/8	920	None
				5 1/2	3630	1855

Describe in detail the manner in which the well was plugged, indicating where the mud fluid was placed and the method or methods used in introducing it into the hole. If cement or other plugs were used, state the character of same and depth placed, from _____ feet to _____ feet for each plug set.

Mudded to 380', set rock bridge from 350' to 380'. Dumped 30 sacks cement to 240' filled balance with rock and mud and capped with 10 sacks cement.

Handwritten: Reed 2-21-68

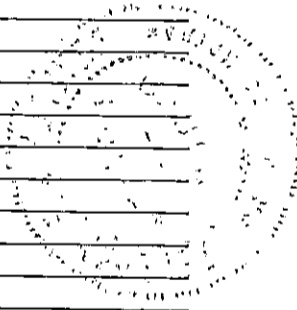

(If additional description is necessary, use BACK of this sheet)

Name of Plugging Contractor Midway Drilling, Inc.
Address P. O. Box 921 Great Bend, Kansas.

STATE OF KANSAS, COUNTY OF BARTON, ss.

_____, (employee of owner) or (owner or operator) of the above-described well, being first duly sworn on oath, says: That I have knowledge of the facts, statements, and matters herein contained and the log of the above-described well as filed and that the same are true and correct. So help me God!

(Signature) John R. Pulley
(Address) _____

SUBSCRIBED AND SWORN TO before me this 26th. day of February, 19 68

My commission expires June 30, 1971

