


15.009.01389.00.01

STATE OF KANSAS
STATE CORPORATION COMMISSION
CONSERVATION DIVISION
P. O. BOX 17027
WICHITA, KANSAS 67217

FORM CP-4

WELL PLUGGING RECORD

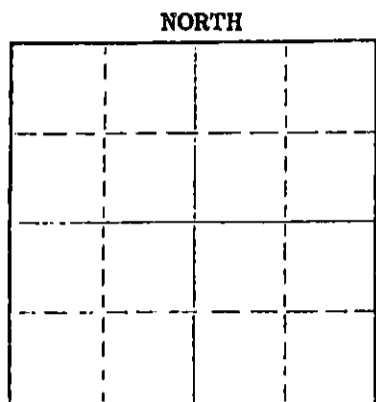

Locate well correctly on above Section Plat

Barton County. Sec. 23 Twp. 19S Rge 14 (E) (W) X
Location as "NE/CNWKSW" or footage from lines NW NE NW
Lease Owner Glen N. Rupe
Lease Name Evers Well No. 1
Office Address 925 O.W. Garvey Bldg., Wichita, KS 67202
Character of Well (completed as Oil, Gas or Dry Hole) D&A
Date well completed February 2 1976
Application for plugging filed February 2 1976
Application for plugging approved February 2 1976
Plugging commenced February 2 1976
Plugging completed February 2 1976
Reason for abandonment of well or producing formation D&A

If a producing well is abandoned, date of last production _____ 19____
Was permission obtained from the Conservation Division or its agents before plugging was commenced? Yes

Name of Conservation Agent who supervised plugging of this well Donald Truan
Producing formation _____ Depth to top _____ Bottom _____ Total Depth of Well 2370' Feet
Show depth and thickness of all water, oil and gas formations.

OIL, GAS OR WATER RECORDS

CASING RECORD

FORMATION	CONTENT	FROM	TO	SIZE	PUT IN	PULLED OUT

Describe in detail the manner in which the well was plugged, indicating where the mud fluid was placed and the method or methods used in introducing it into the hole. If cement or other plugs were used, state the character of same and depth placed, from _____ feet to _____ feet for each plug set.

Mud to 810' w/25 sx
Mud to 350' w/25 sx
Mud to 40' w/1/2 sk hulls, 10 sx
2 sx in rathole.
RECEIVED
CONSERVATION DIVISION
MAR 12 1976
Wichita, Kansas

(If additional description is necessary, use BACK of this sheet)
Name of Plugging Contractor Red Tiger Drilling Company
Address 1720 Wichita Plaza, Wichita, KS 67202

STATE OF Kansas COUNTY OF Sedgwick, ss.
D'Ann Drennan (employee of owner) or (~~owner or operator~~) of the above-described

well, being first duly sworn on oath, says: That I have knowledge of the facts, statements, and matters herein contained and the log of the above-described well as filed and that the same are true and correct. So help me, God.

(Signature) D'Ann Drennan
1720 Wichita Plaza, Wichita, KS 67202
(Address)

Subscribed AND SWORN to before me this 27th day of February, 19 76



Jean Rolla
Notary Public.



ROBERT F. BENNETT	Governor
DALE E. SAFFELS	Chairman
VERNON E. STROBERG	Commissioner
G. T. VAN BEBBER	Commissioner
THELMA M. KNUTSON	Secretary

State Corporation Commission

CONSERVATION DIVISION

(Oil, Gas and Water)
P. O. Box 17027 3830 S. Meridian
WICHITA, KANSAS 67217

Frank -

In talking with Mr. Crawford who is the tool Pusher on the rig that washed down the Evers #1. I found out that they had originally intended to drill a new well on the spot that they had filed the intent to drill. 15-009-20-994.

But later decided to wash the old well down. The old well is located NWNENW of Sec 23-19S-14W. The intent was filed 150' S of NWNENW of Sec 23-19S-14W.

I advised Mr. Crawford to call Mr. Rupe & have him file a new correct intent and also to cancel incorrect one.

Sincerely
Rupee

RECEIVED
STATE CORPORATION COMMISSION

FEB 4 1976

CONSERVATION DIVISION
Wichita, Kansas