


STATE OF KANSAS  
 STATE CORPORATION COMMISSION  
 Give All Information Completely  
 Make Required Affidavit  
 Mail or Deliver Report to:  
 Conservation Division  
 State Corporation Commission  
 800 Biting Building  
 Wichita, Kansas

15.009.00563.00.00  
**WELL PLUGGING RECORD**

Barton County, Sec. 25 Twp. 19 Rge. (E) 13 (W)

Location as "NE/CNW/SW" or footage from lines NE SW SW  
 Lease Owner Chas. Hulme Drilling Contractor  
 Lease Name Moses Well No. 1  
 Office Address P.O. Box 36, Great Bend, Kansas  
 Character of Well (completed as Oil, Gas or Dry Hole) Dry Hole  
 Date well completed May 18 19 55  
 Application for plugging filed May 18 19 55  
 Application for plugging approved May 18 19 55  
 Plugging commenced May 18 19 55  
 Plugging completed May 18 19 55  
 Reason for abandonment of well or producing formation Dry Hole

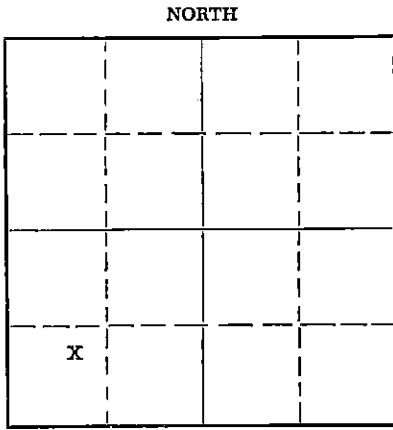

Locate well correctly on above Section Plat

If a producing well is abandoned, date of last production 19  
 Was permission obtained from the Conservation Division or its agents before plugging was commenced? Yes

Name of Conservation Agent who supervised plugging of this well Warren Horner  
 Producing formation \_\_\_\_\_ Depth to top \_\_\_\_\_ Bottom \_\_\_\_\_ Total Depth of Well \_\_\_\_\_ Feet  
 Show depth and thickness of all water, oil and gas formations.

**OIL, GAS OR WATER RECORDS**

**CASING RECORD**

FORMATION	CONTENT	FROM	TO	SIZE	PUT IN	PULLED OUT

Describe in detail the manner in which the well was plugged, indicating where the mud fluid was placed and the method or methods used in introducing it into the hole. If cement or other plugs were used, state the character of same and depth placed, from \_\_\_\_\_ feet to \_\_\_\_\_ feet for each plug set.

300' to 240' with 20 sacks cement through drill pipe; heavy mud 240' to 35';  
10 sacks cement 35' to bottom of cellar

5-27-55

RECEIVED  
 CONSERVATION COMMISSION  
 MAY 27 1955  
 CONSERVATION DIVISION

Name of Plugging Contractor ~~XXXXXX~~ Badger Drillers, Inc  
 Address Great Bend, Kansas

STATE OF Kansas, COUNTY OF Barton, ss.  
C. E. Byars (employee of owner) or (owner or operator) of the above-described well, being first duly sworn on oath, says: That I have knowledge of the facts, statements, and matters herein contained and the log of the above-described well as filed and that the same are true and correct. So help me God.

(Signature) C. E. Byars  
Great Bend, Kansas (Address)

SUBSCRIBED AND SWORN TO before me this 25 day of May, 19 55

My commission expires October 15, 1957  
[Signature] Notary Public.

24-7366-5 3-53-20M

**PLUGGING**  
 FILE SEC 25 19 13W  
 BOOK PAGE 120 LINE 44

15 009.00563.00.00

W E L L L O G

Company - Chas. Hulme Drilling Contractor

Sec. 25 T. 19 R. 13

Farm - Earl C. Moses, Jr.

No. 1

Loc. NE SW SW

Total Depth - 3465'

Comm. - May 10, 1955

Comp. - May 18, 1955

Contractor - Chas. Hulme Drilling Contractor

Casing - 8 5/8" @ 681' w/375 sax

Elevation - 1839 KB

Production - D & A

0	70	Surface Sand
70	170	Sand & Shale
170	174	Sand & Stone
174	679	Shale & Red Bed
679	700	Anhydrite
700	1282	Shale & Shells
1282	1400	Shale
1400	1700	Lime
1700	2720	Shale & Lime
1720	3426	Lime
3426	3465	Chert & Lime
3465		T.D.

Tops:

Heebner: 3027  
 Brown Lime: 3140  
 Lansing: 3152  
 Chert Conglomerate: 3388

State of Kansas )  
 )  
 County of Barton )

ss:

RECEIVED  
 STATE CORPORATION COMMISSION  
 MAY 27 1955  
 CONSERVATION DIVISION

I, C. E. Byars, of Chas. Hulme Drilling Company upon oath state that the above and foregoing is a true and correct copy of the log of the Earl C. Moses, Jr. #1 well.

*C. E. Byars*

Subscribed and sworn to before me this 25th day of May, 1955

*Notary Signature*  
 Notary Public

My Commission Expires: October 15, 1957

PLUGGING  
 SEC 25 T. 19 R. 13W.  
 PAGE 120 LINE 44