


Give All Information Completely
Make Required Affidavit
Mail or Deliver Report to:
Conservation Division
State Corporation Commission
211 No. Broadway
Wichita, Kansas

WELL PLUGGING RECORD

Barton County, Sec. 31 Twp. 19S Rge. (E) 12 (W)

Location as "NE/CNW%SW%" or footage from lines App. Ctr. NE/4 SW/4
Lease Owner Messman-Rinehart Oil Company
Lease Name Wells Well No. 1
Office Address 1432 Wichita Plaza, Wichita, Kansas, 67202
Character of Well (completed as Oil, Gas or Dry Hole) Dry Hole
Date well completed August 15 1966
Application for plugging filed August 15 1966
Application for plugging approved August 15 1966
Plugging commenced August 15 1966
Plugging completed August 15 1966
Reason for abandonment of well or producing formation Dry

NORTH

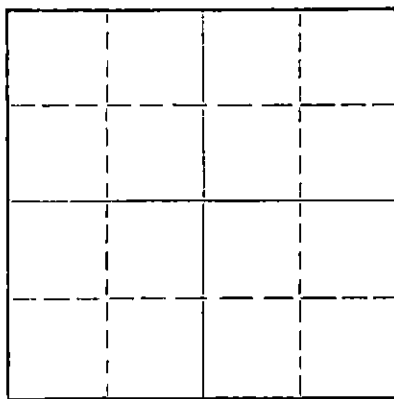

Locate well correctly on above Section Plat

If a producing well is abandoned, date of last production 19
Was permission obtained from the Conservation Division or its agents before plugging was commenced? yes

Name of Conservation Agent who supervised plugging of this well Leo Massey, Box 582, Hays, Kansas
Producing formation Depth to top Bottom Total Depth of Well 3182 Feet
Show depth and thickness of all water, oil and gas formations.

OIL, GAS OR WATER RECORDS

CASING RECORD

FORMATION	CONTENT	FROM	TO	SIZE	PUT IN	PULLED OUT
				8-5/8"	235'	none

Describe in detail the manner in which the well was plugged, indicating where the mud fluid was placed and the method or methods used in introducing it into the hole. If cement or other plugs were used, state the character of same and depth placed, from feet to feet for each plug set.

Set plug at 220 ft. w/25 sx. cement. Set plug at 40 ft. w/10 sx. cement by Globe Cementing Co.

RECEIVED
STATE CORPORATION COMMISSION

SEP 9 1966

CONSERVATION DIVISION
Wichita, Kansas

(If additional description is necessary, use BACK of this sheet)
Name of Plugging Contractor Messman-Rinehart Oil Company
Address 1432 Wichita Plaza, Wichita, Kansas, 67202

STATE OF Kansas COUNTY OF Sedgwick, ss.
J. A. Gilliland (employee of owner)

well, being first duly sworn on oath, says: That I have knowledge of the facts, statements, and matters herein contained and the log of the above-described well as filed and that the same are true and correct. So help me God.

(Signature) J. A. Gilliland
1432 Wichita Plaza, Wichita, Kansas, 67202
(Address)

SUBSCRIBED AND SWORN TO before me this 2nd day of September, 1966

Barbara J. Scott
Barbara J. Scott Notary Public.

My commission expires December 1, 1968

15.009.30460.00.00

NO. 1 WELLS

Well Record:

Location:	App. Ctr. NE/4 SW/4 Section 31-19S-12W Barton County, Kansas	Commenced:	August 6, 1966
Contractor:	Messman-Rinehart Oil Company 1432 Wichita Plaza Wichita, Kansas, 67202	Completed:	August 15, 1966
Operator:	Messman-Rinehart Oil Company 1432 Wichita Plaza Wichita, Kansas, 67202	Elevation:	1825' K/B
Casing Record:	8-5/8" @ 235' w/200 sx cement		
		Production:	D & A

*** L O B ***

(Figures indicate bottom of formation)

Sand	160
Shale	260
Red Bed	850
Anhydrite	865
Shale & Shells	970
Shale	1460
Lime	1665
Lime & Shale	2170
Shale	2465
Shale w/lime streaks	2570
Shale	2685
Lime & Shale	2835
Lime	2920
Lime & Shale	3182 R.T.D.

Sample Tops:

3017 - Heebner (-1192)
 3134 - Brown Lime (-1309)
 3149 - Lansing (-1324)

The undersigned, MESSMAN-RINEHART OIL COMPANY, hereby certifies that the above log is a true and correct log of the formation encountered in drilling the above well as reflected by the daily drilling reports.

MESSMAN-RINEHART OIL COMPANY

By: J. A. Gilliland
J. A. Gilliland

Subscribed and sworn to before me this 25th day of August, 1966

Barbara J. Scott
Barbara J. Scott, Notary Public

My Commission Expires: December 1, 1968

RECEIVED
STATE CORPORATION COMMISSION

SEP 9 1966

CONSERVATION DIVISION
Wichita, Kansas