


WELL PLUGGING RECORD

Give All Information Completely
Make Required Affidavit
Mail or Deliver Report to:
Conservation Division
State Corporation Commission
800 Bitting Building
Wichita, Kansas

NORTH

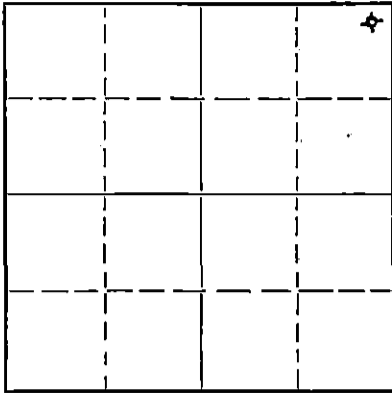

Locate well correctly on above
Section Plat

Barton County, Sec. 27 Twp. 19 Rge. (E) 12 (W)
Location as "NE/CNW $\frac{1}{4}$ /SW $\frac{1}{4}$ " or footage from lines NE NE NE
Lease Owner Graham-Messman-Rinehart Oil Company
Lease Name Koch Well No. 1
Office Address P. O. Box 1033, Wichita, Kansas
Character of Well (completed as Oil, Gas or Dry Hole) Dry Hole
Date well completed February 26, 1953
Application for plugging filed February 26, 1953
Application for plugging approved March 2, 1953
Plugging commenced February 26, 1953
Plugging completed February 26, 1953
Reason for abandonment of well or producing formation Dry Hole

If a producing well is abandoned, date of last production 19
Was permission obtained from the Conservation Division or its agents before plugging was commenced? yes

Name of Conservation Agent who supervised plugging of this well Mr. C. D. Stough, Box 207, Great Bend, Ks.
Producing formation Depth to top Bottom Total Depth of Well 3436 Feet
Show depth and thickness of all water, oil and gas formations.

OIL, GAS OR WATER RECORDS

CASING RECORD

Formation	Content	From	To	Size	Put In	Pulled Out
				8 5/8"	160'	none

Describe in detail the manner in which the well was plugged, indicating where the mud fluid was placed and the method or methods used in introducing it into the hole. If cement or other plugs were used, state the character of same and depth placed, from feet to feet for each plug set.

Bottom plug @ 160' w/20 sx.
cement. Top plug @ 35' w/10
sx. Mud to surface

3-5-53

(If additional description is necessary, use BACK of this sheet)

Name of Plugging Contractor Graham-Messman-Rinehart Oil Company
Address P. O. Box 1033, Wichita, Kansas

STATE OF Kansas, COUNTY OF Sedgwick, ss.
J. A. Gilliland (employee of owner) of the above-described well,

being first duly sworn on oath, says: That I have knowledge of the facts, statements, and matters herein contained and the log of the above-described well as filed and that the same are true and correct. So help me God.

(Signature) *J. A. Gilliland*
P. O. Box 1033, Wichita, Kansas
(Address)

Subscribed and Sworn to before me this 3rd day of March, 1953.

My commission expires December 1, 1956

PLUGGING
FILE SEC 27 T 19 R 12 S
BOOK PAGE 81 LINE 28

KOCH #1

WELL RECORD

Location:	NE-NE-NE Sec. 27-19-12 Barton County, Kansas	Commenced:	February 18, 1953
Operator:	G-M-R Oil Company	Completed:	February 26, 1953
Contractor:	G-M-R Oil Company	Production:	Dry Hole
Casing Record:	8 5/8" @160' w/150 sx. cement	Elevation:	1813 K.B.

LOG

Clay	20
Sand	50
Shale & Shells	155
Sand	160
Sand	210
Shale	530
Shale & Shells	630
Shale & Shells	700
Red Bed & Shale	800
Shale & Shells	1330
Anhydrite	650
Shale & shells	1550
Lime & Shale	1595
Shale & Shells	1735
Shale & Lime	1 835
Lime & Shale	1932
Shale	2135
Shale & Lime	2365
Shale & Lime	2545
Lime & Shale	2685
Lime & Shale	2825
Lime & Shale	2925
Lime & Shale	3025
Lime & Shale	3130
Lime & Shale	3192
Lime	3275
Lime	3295
Lime	3335
Lime	3395
Conglomerate	3421
Arbuckle	3436 T.D.

TOPS

Heebner	2983 (-1170)
Br. Lime	3095 (-1282)
Lansing	3112 (-1299)
Conglomerate	3375 (-1562)
Arbuckle	3412 (-1599)

RECEIVED
 MAR 5 1953
 BARTON COUNTY, KANSAS
 NOTARY PUBLIC

The Undersigned, Graham-Messman-Rinehart Oil Company, hereby certifies that the above log is a true and correct log of the formations encountered in drilling the above well as reflected by the Daily Drilling Reports.

GRAHAM-MESSMAN-RINEHART OIL COMPANY

By J. A. Gilliland
J. A. Gilliland

Subscribed and sworn to before me this 3rd day of March, 1953.

Barbara J. Scott
Notary Public

My commission expires December 1, 1956.

PLUGGING
 FILE SEC 27 T 19 R 1234
 BOOK PAGE 81 LINE 38