


15.009.01142.00.00

WELL PLUGGING RECORD

Give All Information Completely  
Make Required Affidavit  
Mail or Deliver Report to:  
Conservation Division  
State Corporation Commission  
211 No. Broadway  
Wichita, Kansas

Barton County. Sec. 25 Twp. 19 Rge. 12 (E) W (W)

Location as "NE/CNW/SW" or footage from lines NE SE SW  
Lease Owner Lee Phillips Oil Co.  
Lease Name Hammeke "B" Well No. 1  
Office Address 1407 Union National Bank Bldg., Wichita, Kansas  
Character of Well (completed as Oil, Gas or Dry Hole) Dry Hole  
Date well completed May 12, 19 58  
Application for plugging filed May 12, 19 58  
Application for plugging approved May 12, 19 58  
Plugging commenced May 12, 19 58  
Plugging completed May 12, 19 58  
Reason for abandonment of well or producing formation Dry Hole

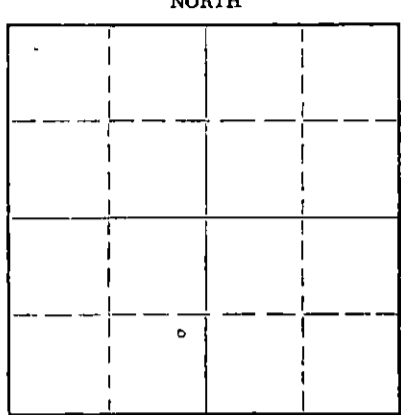

Locate well correctly on above Section Plat

If a producing well is abandoned, date of last production \_\_\_\_\_ 19 \_\_\_\_  
Was permission obtained from the Conservation Division or its agents before plugging was commenced? Yes

Name of Conservation Agent who supervised plugging of this well Donald Truan  
Producing formation \_\_\_\_\_ Depth to top \_\_\_\_\_ Bottom \_\_\_\_\_ Total Depth of Well 3112 Feet  
Show depth and thickness of all water, oil and gas formations.

OIL, GAS OR WATER RECORDS

CASING RECORD

FORMATION	CONTENT	FROM	TO	SIZE	PUT IN	PULLED OUT
Surface		0	280	8 5/8"	280	none

Describe in detail the manner in which the well was plugged, indicating where the mud fluid was placed and the method or methods used in introducing it into the hole. If cement or other plugs were used, state the character of same and depth placed, from \_\_\_\_\_ feet to \_\_\_\_\_ feet for each plug set.

Filled hole with heavy mud from total depth to 275' with plug and 25 sacks of cement at this point. Filled with heavy mud to 40' with plug and 10 sacks of cement.

*Handwritten signature and date: 7-58*

(If additional description is necessary, use BACK of this sheet)

Name of Plugging Contractor Harms-Burt Drilling Company  
Address P. O. Box 184, Great Bend, Kansas

STATE OF Kansas, COUNTY OF Barton, ss.  
Allan Harms (employee of owner) or (owner or operator) of the above-described well, being first duly sworn on oath, says: That I have knowledge of the facts, statements, and matters herein contained and the log of the above-described well as filed and that the same are true and correct. So help me God.

(Signature) Allan Harms  
P. O. Box 184, Great Bend, Kansas  
(Address)

SUBSCRIBED AND SWORN TO before me this 3 day of JUNE, 19 58  
Mary E Van Pelt  
Notary Public.

My commission expires 1-20-62

PLUGGING  
FILE SEC 25 T. 19 R. 12W  
BOOK - PAGE 102 LINE 16

15.009.01142.00.00

DRILLERS LOG

Company: Lee Phillips Oil Co.

NE SE SW Section 25-19-12W

Farm: Hammeke #1 "B"

Barton County, Kansas

Commenced: May 5, 1958

Completed: May 12, 1958

Elevation: 1799 KB

0 - 150	sand
150 - 165	iron H-sand
165 - 280	shale
280 - 600	shale & red bed
600 - 620	anhydrite
620 - 830	red bed
830 - 1400	shale & shells
1400 - 1490	shale & lime
1490 - 2000	lime
2000 - 2295	lime & shale
2295 - 2715	shale & lime
2715 - 2785	lime & shale
2785 - 2978	lime
2978 - 2981	Heebner Shale
2981 - 3045	lime
3045 - 3099	shale
3099 - 3112	Brown Lime
3112	Total depth

Set 280' of 8 5/8" surface pipe. Cemented with 250 sacks of common cement 2% calcium chloride.

Tops: Anhydrite - 600  
 Heebner - 2978  
 Brown Lime - 3099

Dry, plugged, and abandoned.

AFFIDAVIT

State of Kansas )  
                  )SS  
County of Barton)

I, Allan Harms of the Harms-Burt Drilling Company being first duly sworn on oath state: I have knowledge of the facts, statements and matters herein contained and the same are true and correct.

Allan Harms

Subscribed and sworn to before me this 3 day of JUNE 1958.

Mary E Van Pelt

Notary Public

My commission expires January 20, 1962.

RECEIVED

JUN 17 1958

PLUGGING			
FILE	SEC. 25 T.	19 R.	12W
BOOK	PAGE 102	LINE	16