


STATE OF KANSAS  
STATE CORPORATION COMMISSION

15.009.06219.00.00

Give All Information Completely  
Make Required Affidavit  
Mail or Deliver Report to:  
Conservation Division  
State Corporation Commission  
212 North Market, Insurance Bldg.  
Wichita, Kansas

WELL PLUGGING RECORD

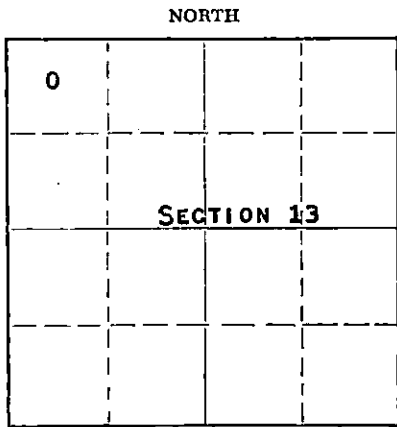

Locate well correctly on above Section Plat

BARTON County. Sec. 13 Twp. 19S Rge. 12W (#)      (W)

Location as "NE/CNWxSWx" or footage from lines SW NW NW

Lease Owner PETROLEUM, INC.

Lease Name HAMMEKE "C" Well No. 1

Office Address ROUTE 2, GREAT BEND, KANSAS

Character of Well (completed as Oil, Gas or Dry Hole) DRY HOLE

Date well completed OCTOBER 12 1959

Application for plugging filed OCTOBER 12 1959

Application for plugging approved OCTOBER 12 1959

Plugging commenced OCTOBER 12 1959

Plugging completed OCTOBER 12 1959

Reason for abandonment of well or producing formation NO PRODUCIBLE ZONES

If a producing well is abandoned, date of last production NONE 19    

Was permission obtained from the Conservation Division or its agents before plugging was commenced? YES

Name of Conservation Agent who supervised plugging of this well DONALD TRUAN, 634 SUNSET, RUSSELL, KANSAS

Producing formation      Depth to top      Bottom      Total Depth of Well 3425 Feet

Show depth and thickness of all water, oil and gas formations.

OIL, GAS OR WATER RECORDS

CASING RECORD

FORMATION	CONTENT	FROM	TO	SIZE	PUT IN	PULLED OUT
				8-5/8"	250'	NONE

Describe in detail the manner in which the well was plugged, indicating where the mud fluid was placed and the method or methods used in introducing it into the hole. If cement or other plugs were used, state the character of same and depth placed, from      feet to      feet for each plug set.

MUD UP WITH HEAVY MUD TO 240' FOLLOWED BY A WOODEN PLUG AND 1/4 SACK OF HULLS.

PLACED 20 SACKS CEMENT THROUGH DRILL PIPE ON TOP OF PLUG. MUD UP TO 35' FOLLOWED BY A WOODEN PLUG AND 1/4 SACK OF HULLS, FILLED HOLE TO BASE OF WELL CELLAR WITH 10 SACKS OF CEMENT.

**RECEIVED**  
STATE CORPORATION COMMISSION  
OCT 26 1959  
CONSERVATION DIVISION  
Wichita, Kansas

(If additional description is necessary, use BACK of this sheet)

Name of Plugging Contractor GARVEY DRILLING COMPANY

Address ROUTE, GREAT BEND, KANSAS

STATE OF KANSAS COUNTY OF BARTON, ss.  
DON SEARLE

(employee of owner) or (~~owner~~) of the above-described well, being first duly sworn on oath, says: That I have knowledge of the facts, statements, and matters herein contained and the log of the above-described well as filed and that the same are true and correct. So help me God.

(Signature) Don Searle

ROUTE 2, GREAT BEND, KANSAS  
(Address)

SUBSCRIBED AND SWORN TO before me this 21ST day of OCTOBER, 1959

Arthur J. Wiles  
ARTHUR J. WILES Notary Public.

My commission expires APRIL 14, 1963



15. 009. 06219. 00. 00.  
WELL LOG

COMPANY PETROLEUM, INCORPORATED

SEC. 13 T. 19S R. 12W

FARM HAMMEKE "C" NO. 1


LOC. SW, NW, NW

TOTAL DEPTH 3425'

COUNTY BARTON CO., KANSAS

COMM. October 5, 1959 COMP. October 12, 1959

CONTRACTOR GARVEY DRILLING COMPANY

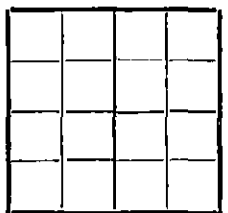

CASING 8 5/8" @ 250' W/175 sax.

ELEVATION 1825' KB

PRODUCTION D & A

FIGURES INDICATE BOTTOM OF FORMATIONS

250	Surface clay & shale
640	Shale & red bed
672	Anhydrite
1225	Shale & shells
1400	Shale
1725	Salt, shale & shells
1960	Shale & lime
2095	Lime & shale
2250	Lime
2450	Shale & shells
2640	Shale, shells & lime
2985	Lime
3110	Shale & lime
3225	Lime
3425	Lime & shale
3425	T. D.

RECEIVED  
STATE CORPORATION COMMISSION  
OCT 26 1959  
CONSERVATION DIVISION  
Wichita, Kansas

State of KANSAS  
County of BARTON } ss:

I, VERNE A. MORRIS of GARVEY DRILLING COMPANY

upon oath state that the above and foregoing is a true and correct copy of the log of the #1 HAMMEKE "C" well.

Verne A. Morris

Subscribed and sworn to before me this 20th day of October 19 59

My Commission Expires: April 14, 1963

Arthur J. Miles  
NOTARY PUBLIC