


15.009.30898.00.00

WELL PLUGGING RECORD

Give All Information Completely
Make Required Affidavit
Mail or Deliver Report to:
Conservation Division
State Corporation Commission
212 North Market, Insurance Bldg.
Wichita, Kansas

NORTH

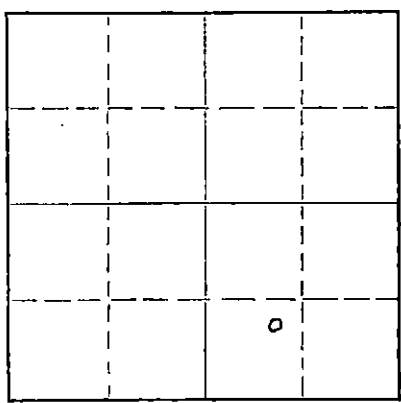

Locate well correctly on above Section Plat

Barton County. Sec. 8 Twp. 19S Rge. 12 ~~NE~~ W (W)
Location as "NE/CNW/SW" or footage from lines NE SW SE
Lease Owner ~~XXXXXX~~ Raymond Oil Company, Inc.
Lease Name Rusco Well No. 1
Office Address 410 Fourth National Bank Bldg., Wichita, Kansas
Character of Well (completed as Oil, Gas or Dry Hole) Dry Hole
Date well completed June 9 19 61
Application for plugging filed July 12 19 61
Application for plugging approved July 18 19 61
Plugging commenced Aug. 17 19 61
Plugging completed Aug. 21 19 61
Reason for abandonment of well or producing formation _____

If a producing well is abandoned, date of last production July 9 19 61
Was permission obtained from the Conservation Division or its agents before plugging was commenced? Yes

Name of Conservation Agent who supervised plugging of this well Don Truin
Producing formation Arbuckle Depth to top 3405 Bottom 3428 Total Depth of Well 3428 Feet
Show depth and thickness of all water, oil and gas formations.

OIL, GAS OR WATER RECORDS

CASING RECORD


FORMATION	CONTENT	FROM	TO	SIZE	PUT IN	PULLED OUT
				8-5/8"	230	
				5-1/2"	3405	2641

Describe in detail the manner in which the well was plugged, indicating where the mud fluid was placed and the method or methods used in introducing it into the hole. If cement or other plugs were used, state the character of same and depth placed, from _____ feet to _____ feet for each plug set.

Filled back to 3390' with sand and gravel. Dumped 5 sacks of cement. Shot pipe off at 2641'. Pulled pipe and squeezed 20 sacks of jell mud and 80 sacks of cement with Halliburton.

RECEIVED
STATE CORPORATION COMMISSION
AUG 31 1961
CONSERVATION DIVISION
Wichita, Kansas

(If additional description is necessary, use BACK of this sheet)
Name of Plugging Contractor Bert Self Casing Pulling Company
Address R R #4 - Hutchinson, Kansas

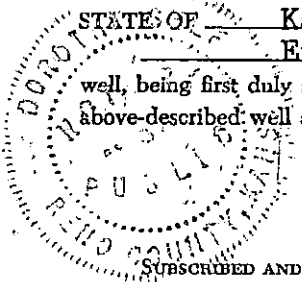

STATE OF Kans. COUNTY OF Reno, ss.
Employee (employee of owner) or (owner or operator) of the above-described well, being first duly sworn on oath, says: That I have knowledge of the facts, statements, and matters herein contained and the log of the above-described well as filed and that the same are true and correct. So help me God.
(Signature) Bert Self
R. R. #4, Hutchinson, Kans. (Address)
SUBSCRIBED AND SWORN TO before me this 24th day of August, 19 61

My commission expires August 12, 1962 Dorothy Selby Notary Public.

Raymond Oil Company, Inc. #1 RUSCO
 NE SW SE, 8-19S-12W
 Barton County, Kansas

15.009.30898.00.00

Elevation. 1853 KB
 1850 DF
 1847 GL

Contractor. Company Tools, Rig#1
 Commenced: May 30, 1961
 Completed: June 9, 1961 (rotary)

Casing Record:
 8-5/8" @ 230' w/200 sx. 2% CC
 5-1/2" @ 3405' w/100 ex.

Figures Indicate Bottom of Formation

<u>Formation</u>	<u>Depth</u>
Surface Hole	230
Pyritic sand	290
Shale, Red Bed, & Shells	715
Anhydrite	745
Shale & Shells	1120
Shale & shells w/salt	1380
Shale & shells w/lime	1440
Lime with shale	1675
Lime and shale	1840
Sand	1860
Lime and shale	2174
Shale and lime	2825
Lime with shale	2935
Lime	3022
Shale	3025
Lime	3032
Shale	3040
Lime	3056
Shale	3133
Lime	3140
Shale	3146
Lime	3381
Shale	3394
Chert & shale	3400
Dolomite	3428
Tops:	
Anhydrite (driller's)	710
Heebner	3022
Toronto	3040
Douglas	3056
Brown Lime	3133
Lansing	3146
Base Kansas City	3381
Conglomerate	3394
Arbuckle	3400
Rotary Total Depth	3428

RECEIVED
 STATE CORPORATION COMMISSION
 OCT 12 1961
 CONSERVATION DIVISION
 Wichita, Kansas

STATE OF KANSAS)
) SS
 COUNTY OF SEDGWICK

I hereby certify that the above is true and correct to the best of my knowledge.

Rick P. Clinton
 Rick P. Clinton

Subscribed and sworn to before me this 15th day of June, 1961.

James C. Bohannon
 Notary Public

My Commission Expires:
 April 18, 1963