


STATE OF KANSAS  
STATE CORPORATION COMMISSION

Give All Information Completely  
Make Required Affidavit  
Mail or Deliver Report to:  
Conservation Division  
State Corporation Commission  
800 Bittling Bldg.  
Wichita, Kansas

15.009.14/86.00.00

WELL PLUGGING RECORD

NORTH

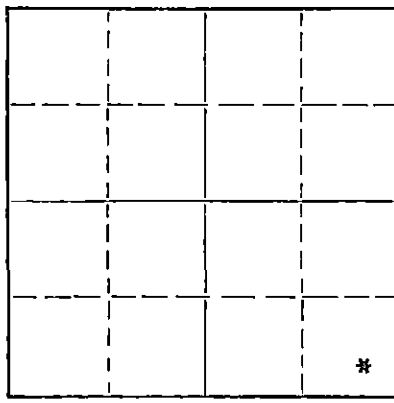

Locate well correctly on above  
Section Plat

Barton County, Sec. 2 Twp. 19 Rge. 12 (E) (W)

Location as "NE/CNW%SW%" or footage from lines SE SE SE  
Lease Owner H. W. Muir  
Lease Name Tomberlin Well No. 1  
Office Address 2727 Main Hutchinson, Kansas  
Character of Well (completed as Oil, Gas or Dry Hole) dry hole  
Date well completed March 8 19 56  
Application for plugging filed March 8 19 56  
Application for plugging approved March 8 19 56  
Plugging commenced March 8 19 56  
Plugging completed March 8 19 56  
Reason for abandonment of well or producing formation dry hole

If a producing well is abandoned, date of last production \_\_\_\_\_ 19 \_\_\_\_  
Was permission obtained from the Conservation Division or its agents before plugging was commenced? Yes

Name of Conservation Agent who supervised plugging of this well R. M. Brundage  
Producing formation \_\_\_\_\_ Depth to top \_\_\_\_\_ Bottom \_\_\_\_\_ Total Depth of Well 3407 Feet  
Show depth and thickness of all water, oil and gas formations.

OIL, GAS OR WATER RECORDS

CASING RECORD

FORMATION	CONTENT	FROM	TO	SIZE	PUT IN	PULLED OUT
Surface pipe		-0-	224	8 5/8	224	-0-

Describe in detail the manner in which the well was plugged, indicating where the mud fluid was placed and the method or methods used in introducing it into the hole. If cement or other plugs were used, state the character of same and depth placed, from \_\_\_\_\_ feet to \_\_\_\_\_ feet for each plug set.

Filled hole with heavy mud.  
Pumped 90 sacks cement through swedge  
Nippled with 75# pressure  
By Globe Oilwell Cementing, Inc.

(If additional description is necessary, use BACK of this sheet)  
Name of Plugging Contractor Globe Oilwell Cementing, Inc.  
Address Box 628 Great Bend, Kansas

STATE OF Kansas, COUNTY OF Barton, ss.  
A. L. Jackson ~~Employer of owner~~ (owner or operator) of the above-described well, being first duly sworn on oath, says: That I have knowledge of the facts, statements, and matters herein contained and the log of the above-described well as filed and that the same are true and correct. So help me God.

(Signature) A. L. Jackson  
Box 194 Great Bend, Kansas  
(Address)

SUBSCRIBED AND SWORN TO before me this 10th day of March, 19 56

My commission expires April 27, 1957

Walter E. Reel  
Notary Public.

**PLUGGING**  
FILE SEC 2 T 19 R 12W  
BOOK PAGE 44 LINE 41

CONSERVATION DIVISION  
Wichita, Kansas

5-1-56

Well Log  
Tomberlin #1  
SE SE SE 2-19-12  
Barton County, Kansas

0 - 155	Sand and clay
155 - 190	Shale
190 - 200	Sand
200 - 224	Sand and shale
224 - 315	Shale and shells
315 - 460	Shale and sand
460 - 640	Red bed and shale
640 - 665	Anhydrite
665 - 895	Shale and shells
895 - 1115	Shale
1115 - 1220	Salt and shale
1220 - 1495	Shale and shells
1495 - 1665	Shale and lime
1665 - 1795	Lime and sand
1795 - 1895	Lime
1895 - 2035	Shale and lime
2035 - 2200	Lime
2200 - 2570	Shale and lime
2570 - 2705	Shale and shells
2705 - 2933	Lime and shale
2933 - 2964	Lime
2964 - 3147	Shale and lime
3147 - 3220	Lime
3220 - 3282	Lime and pyrite
3282 - 3380	Lime
3380 - 3387	Conglomerate
3387 - 3393	Arbuckle lime
3393 - 3407	Lime
3407	T. D.

STATE OF KANSAS

COUNTY OF BARTON ss

A. L. Jackson, owner of A. L. Jackson Drilling Company, being first duly sworn on oath says: That I have knowledge of the facts, statements, and matters herein contained and the log of the above described well as filed and that the same are true and correct.

A. L. Jackson  
A. L. Jackson

Subscribed and sworn before me this 10th day of March, 1956

Virgil E. Belford  
Virgil E. Belford, Jr.  
Notary Public Barton County

My Commission expires April 27, 1957

STATE OF KANSAS  
COMMISSION EXPIRES

MAR 23 1956

CONSERVATION DIVISION  
Wichita, Kansas

<b>PLUGGING</b>			
FILE	SEC 2	T 19	R 12W
BOOK	PAGE 44	LINE 41	