


WELL PLUGGING RECORD

Give All Information Completely  
Make Required Affidavit  
Mail or Deliver Report to:  
Conservation Division  
State Corporation Commission  
800 Bittling Building  
Wichita, Kansas

Barton County. Sec. 16 Twp. 19S Rge. 11W (W)

Location as "NE/CNW $\frac{1}{4}$ SW $\frac{1}{4}$ " or footage from lines NE NE NE  
Lease Owner C. E. Ash & L. B. Smith  
Lease Name Bernard Musenberg "C" Well No. 1  
Office Address 309 Petroleum Bldg., Wichita 2, Kansas  
Character of Well (completed as Oil, Gas or Dry Hole) Dry  
Date well completed August 27, 19 51  
Application for plugging filed August 27, 19 51  
Application for plugging approved August 27, 19 51  
Plugging commenced August 27, 19 51  
Plugging completed August 27, 19 51  
Reason for abandonment of well or producing formation

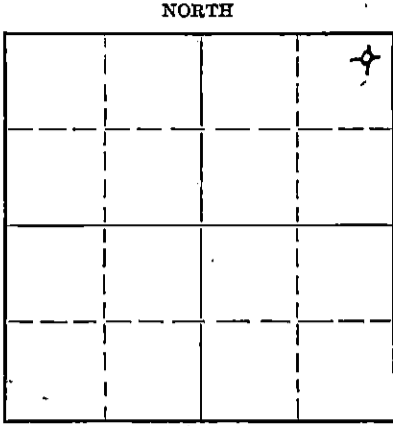

Locate well correctly on above Section Plat

If a producing well is abandoned, date of last production 19  
Was permission obtained from the Conservation Division or its agents before plugging was commenced? Yes

Name of Conservation Agent who supervised plugging of this well C. D. Stough, Great Bend, Kansas  
Producing formation Arbuckle Depth to top 3356' Bottom 3384' Total Depth of Well 3384' Feet  
Show depth and thickness of all water, oil and gas formations.

OIL, GAS OR WATER RECORDS

CASING RECORD

| Formation | Content | From  | To    | Size   | Put In | Pulled Out |
|-----------|---------|-------|-------|--------|--------|------------|
| Arbuckle  | Water   | 3356' | 3384' | 8-5/8" | 226'   | None       |
|           |         |       |       |        |        |            |
|           |         |       |       |        |        |            |
Describe in detail the manner in which the well was plugged, indicating where the mud fluid was placed and the method or methods used in introducing it into the hole. If cement or other plugs were used, state the character of same and depth placed, from \_\_\_\_\_ feet to \_\_\_\_\_ feet for each plug set.

Mudded with Rotary Mud from 3384' to 210'  
Set Wood Plug at 210', 5' Rock then cemented with 15 Sacks Cement  
Mudded to 40'.  
Set wood plug at 40', 5' Rock then cemented with 10 sacks cement.

9-6-51  
RECEIVED  
STATE CORPORATION COMMISSION  
SEP 6 X 1951  
CONSERVATION DIVISION  
Wichita, Kansas

Name of Plugging Contractor C. E. Ash  
Address 309 Petroleum Bldg., Wichita 2, Kansas.

STATE OF KANSAS, COUNTY OF SEDGWICK, SS.  
C. E. Ash (employee of owner) or (owner or operator) of the above-described well,  
being first duly sworn on oath, says: That I have knowledge of the facts, statements, and matters herein contained and the log of the above-described well as filed and that the same are true and correct. So help me God.

(Signature) C. E. Ash  
309 Petroleum Bldg., Wichita, Kansas  
(Address)

SUBSCRIBED AND SWORN to before me this 5th day of September, 19 51

Charles J. Palintz  
Notary Public.

My commission expires October 31, 1951

PLUGGING  
FILE SEC 16 T 19 R 16 W  
BOOK PAGE 106 LINE 17

ASH & SMITH  
Bernard Musenberg "C" # 1  
NE NE NE Section 16-19S-11W,  
Barton County, Kansas

Comm. Rig Up: 8-13-51  
Comm. Drlg. : 8-16-51  
Comp. R. D. : 8-27-51  
Completed : 8-27-51  
Total Depth : 3384'

Elevation : 1768'  
Initial Prod.: Dry  
Contractor : C. E. Ash  
Tools : Rotary

CASING RECORD  
Pulled

Run Left In  
226' 8-5/8" Surface Casing 226' 8-5/8" Surface Casing  
cemented w/115 Sks Cement

| STRATA             | DEPTH | FORMATION TOPS                          | DERRICK FLOOR |
|--------------------|-------|---|---------------|
| Clay               | 10    | Topeka                                  | ( -881)       |
| Sand               | 80    | Heebner Shale                           | (-1147)       |
| Shale              | 150   | Dodge                                   | (-1165)       |
| Shale & sand       | 200   | Brown Lime                              | (-1267)       |
| Shale & Shells     | 265   | Lansing                                 | (-1288)       |
| Red Bed            | 560   | Cherty Conglomerate                     | (-1569)       |
| Anhydrite          | 590   | Arbuckle                                | (-1588)       |
| Shale              | 850   |   |               |
| Sandy Lime         | 970   | D.S.T. 3185' to 3203' Open 25 Min. Rec. |               |
| Shale              | 1030  | 10' of Drilling Mud. 310# B.H.P.        |               |
| Salt               | 1205  |   |               |
| Shale              | 1320  | D & A                                   |               |
| Sandy Lime & Shale | 1785  |   |               |
| Lime               | 1870  |   |               |
| Lime & Shale       | 2785  |   |               |
| Lime               | 2825  |   |               |
| Shale & Lime       | 3075  |   |               |
| Lime               | 3095  |   |               |
| Lime & Shale       | 3304  |   |               |
| Lime               | 3311  |   |               |
| Shale              | 3355  |   |               |
| Lime               | 3384  |   |               |
| TOTAL DEPTH        | 3384  |   |               |

I hereby certify that the above is a true and correct log of said well as reflected by the daily drilling reports.

C. E. Ash  
C. E. ASH

STATE OF KANSAS, COUNTY OF SEDGWICK  
Subscribed and sworn to before me this 5th day of September 1951.

Charles L. Roberts  
Notary Public

My Commission expires: October 31, 1951

RECEIVED  
STATE CORPORATION COMMISSION  
SEP 6 X 1951  
CONSERVATION DIVISION  
Wichita, Kansas

PLUGGING  
FILE SEC-16T-19-RLW  
BOOK PAGE 106 LINE 17