


STATE OF KANSAS
STATE CORPORATION COMMISSION

Give Information Completely
Make Required Affidavit
Mail Delivered Report to:
Conservation Division
State Corporation Commission
800 Bittling Building
Wichita, Kansas

15.009.00161.00.00
WELL PLUGGING RECORD

NORTH

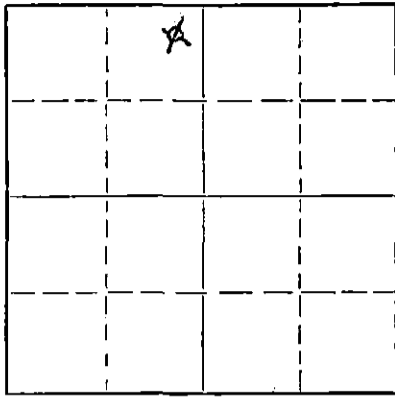

Locate well correctly on above
Section Plat

Barton County. Sec. 16 Twp. 19 Rge. 11 (X) (W)
Location as "NE/CNW/SW" or footage from lines. NE NE NW
Lease Owner C. E. Ash - L. B. Smith
Lease Name Bieberle "A" Well No. 2
Office Address 309 Petroleum Bldg., Wichita, Kansas
Character of Well (completed as Oil, Gas or Dry Hole) Dry
Date well completed September 6, 1952
Application for plugging filed September 6, 1952
Application for plugging approved September 6, 1952
Plugging commenced September 6, 1952
Plugging completed September 6, 1952
Reason for abandonment of well or producing formation

If a producing well is abandoned, date of last production 19
Was permission obtained from the Conservation Division or its agents before plugging was commenced? Yes

Name of Conservation Agent who supervised plugging of this well C. D. Stough
Producing formation Arbuckle Lime Depth to top 3363 Bottom 3386 Total Depth of Well 3386 Feet
Show depth and thickness of all water, oil and gas formations.

OIL, GAS OR WATER RECORDS

CASING RECORD

FORMATION	CONTENT	FROM	TO	SIZE	PUT IN	PULLED OUT
Arbuckle Lime	Dry	3363	3386	8-5/8"	229'	None

Describe in detail the manner in which the well was plugged, indicating where the mud fluid was placed and the method or methods used in introducing it into the hole. If cement or other plugs were used, state the character of same and depth placed, from feet to feet for each plug set.

Mudded from 3386' to 210'
Set Wood Plug at 210' 5' Rock 210' up to 205'
Cemented with 20 Sacks Cement at 205' through drill pipe
Mudded from 205' to 35'
Set Wood Plug at 35' 5' Rock from 35' to 30'
Cemented with 10 Sacks Cement, then filled to surface with dirt.

RECEIVED
STATE CORPORATION COMMISSION
SEP 13 1952
CONSERVATION DIVISION
Wichita, Kansas

(If additional description is necessary, use BACK of this sheet)
Name of Plugging Contractor C. E. Ash
Address 309 Petroleum Building, Wichita, Kansas

STATE OF Kansas, COUNTY OF Sedgwick, ss.
C. E. Ash, Owner (employee of owner) or (owner or operator) of the above-described well, being first duly sworn on oath, says: That I have knowledge of the facts, statements, and matters herein contained and the log of the above-described well as filed and that the same are true and correct. So help me, God.

(Signature) *C. E. Ash*
309 Petroleum Bldg., Wichita, 2, Kansas
(Address)

SUBSCRIBED AND SWORN TO before me this 12th day of September, 1952

My commission expires My Commission Expires Oct. 31, 1955. *Charles J. Roberts* Notary Public.

PLUGGING
FILE SEC 16 T 19 R 44
BOOK PAGE 43 LINE 18

15.009.00/61.00.00

ASH & SMITH
Bieberle A #2
NE NE NW Sec. 16-19-11
Barton County, Kansas

Comm. Rig up: 8-24-52
Comm. Drlg.: 8-27-52
Comp. Rotary Drlg. 9-6-52
Total Depth: 3386'

Elevation : 1769'
Initial Prod.: D & A
Contractor : C. E. Ash
Tools : Rotary

CASING RECORD

Run Pulled Left in
229' 8-5/8" Surface Casing 229' 8-5/8" Surface
Cemented with 118 sacks Casing
Monarch Cement

STRATA	DEPTH	FORMATION TOPS	DERRICK FLOOR
Clay	15	Topeka Lime	2666 (-897)
Sand	60	Heebner Shale	2927 (-1158)
Shale	150	Dodge Lime	2946 (-1177)
Sand & Shale	185	Brown Lime	3046 (-1277)
Shale & Shells	265	Lansing Lime	3064 (-1295)
Red Bed	555	Conglomerate Sand	3342 (-1573)
Anhydrite	590	Conglomerate Cherty	3354 (-1585)
Shale & Shells	1035	Arbuckle Lime	3363 (-1594)
Salt	1240		
Lime & Shale	2845	Show oil 3154-3159	
Lime	2930	D.S.T. 3147-3161 Open 55 Min.	
Shale & Lime	3090	Weak blow throughout. Recovered	
Lime	3161	120' gas and 20' slightly oil cut	
Shale & Lime	3235	mud. 60# B.H.P.	
Lime	3305		
Lime & Shale	3386	D & A	
TOTAL DEPTH	3386		

I hereby certify that the above is a true and correct log of said well as reflected by the daily drilling reports.

C. E. Ash

STATE OF KANSAS, COUNTY OF SEDGWICK

Subscribed and sworn to before me this 12th day of September, 1952.

Notary Public

My commission expires October 31, 1955.

PLUGGING
FILE SEC 16 T 19 R 4 W
BOOK PAGE 42 LINE 12

RECEIVED
STATE CORPORATION COMMISSION
SEP 13 1952
CONSERVATION DIVISION
Wichita, Kansas