

15.009.01524.00.00

STATE OF KANSAS
STATE CORPORATION COMMISSION

Form CP-4

Give All Information Completely
Make Required Affidavit
Mail or Deliver Report to:
Conservation Division
State Corporation Commission
211 No. Broadway
Wichita, Kansas

WELL PLUGGING RECORD

Barton County, Sec. 14 Twp. 19S Rge. 11W (E) (W)

Location as "NE/CNW/SW" or footage from lines SE NE NE

Lease Owner Mayfield-Smith Drilling, Inc. - Robinowitz Oil Company

Lease Name WILLENBERG Well No. One

Office Address 928 Union Center Building - Wichita 2, Kansas

Character of Well (completed as Oil, Gas or Dry Hole) Dry Hole

Date well completed April 18, 1964 19

Application for plugging filed April 18, 1964 19

Application for plugging approved April 18, 1964 19


Plugging commenced April 18, 1964 19

Plugging completed April 18, 1964 19

Reason for abandonment of well or producing formation No oil found in commercial quantities.

If a producing well is abandoned, date of last production _____ 19

Was permission obtained from the Conservation Division or its agents before plugging was commenced? Yes

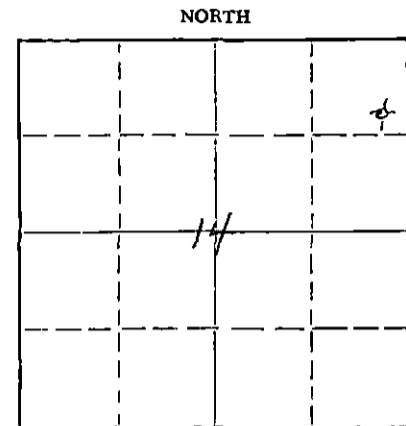

Locate well correctly on above Section Plat

Name of Conservation Agent who supervised plugging of this well Gilbert Toman - Russell, Kansas

Producing formation _____ Depth to top _____ Bottom _____ Total Depth of Well 3385' Feet

Show depth and thickness of all water, oil and gas formations.

OIL, GAS OR WATER RECORDS

CASING RECORD

FORMATION	CONTENT	FROM	TO	SIZE	PUT IN	PULLED OUT
				8 5/8"	208'	None

Describe in detail the manner in which the well was plugged, indicating where the mud fluid was placed and the method or methods used in introducing it into the hole. If cement or other plugs were used, state the character of same and depth placed, from _____ feet to _____ feet for each plug set.

Filled hole with heavy rotary mud to 200'. Set first plug with 20 sacks cement. Filled hole to 40', set second plug with 10 sacks cement and filled to base of cellar, 2 sacks cement in rat hole.

RECEIVED
STATE CORPORATION COMMISSION

APR 27 1964

CONSERVATION DIVISION
Wichita, Kansas

4-27-64

(If additional description is necessary, use BACK of this sheet)

Name of Plugging Contractor Mayfield-Smith Drilling, Inc.
Address 928 Union Center Building - Wichita 2, Kansas


STATE OF Kansas, COUNTY OF Sedgwick, ss.
I, Edgar E. Smith - Partner (employee of owner) or (owner or operator)

of the above-described well, being first duly sworn on oath, says: That I have knowledge of the facts, statements, and matters herein contained and the log of the above-described well as filed and that the same are true and correct. So help me God.

(Signature) Edgar E. Smith

928 Union Center Building - Wichita 2, Kansas
(Address)

Subscribed and Sworn to before me this 22nd day of April, 19 64

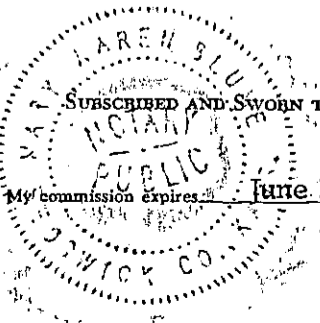

Mary Karen Blume
Mary Karen Blume Notary Public.

MAYFIELD-SMITH DRILLING, INC.

UNION CENTER BUILDING

WICHITA, KANSAS

OFFICE AM 5-2293



Re: Mayfield-Smith Drlg. Inc.-Robinowitz Oil Co.
#1 WILLENBERG
SE NE NE, Section 14-19S-11W
Barton County, Kansas

DRILLERS LOG

Date Started: April 12, 1964

Date Completed: April 18, 1964

Casing: Set 208' 8 5/8" with 150 sacks cement

0 - 180	Sand			
180 - 208	Blue Shale	Elevation:	TOPS: 1783' Kelly Bushing	
208 - 534	Shale and Shells			
534 - 560	Anhydrite	Anhydrite	534'	+1249
560 - 1631	Shale and Shells	Heebner	2918'	-1135
1631 - 1840	Lime and Shale	Brown Lime	3037'	-1254
1840 - 2220	Shale and Lime	Lansing	3052'	-1269
2220 - 2607	Lime and Shale	Conglomerate	3331'	-1548
2607 - 2765	Lime	Arbuckle	3344'	-1561
2765 - 2875	Lime and Shale	Total Depth	3385'	-1602
2875 - 2963	Lime			
2963 - 3075	Lime and Shale			
3075 - 3354	Lime			
3354 - 3385	Arbuckle			

RECEIVED
STATE CORPORATION COMMISSION

APR 27 1964

CONSERVATION DIVISION
Wichita, Kansas

AFFIDAVIT

State of Kansas)
) SS
County of Sedgwick)

I, Edgar E. Smith do hereby certify that the above and foregoing is a true and correct Log of the #1 Willenberg, located in the SE NE NE, Section 14, Township 19-South, Range 11-West, Barton County, Kansas, as reflected by the Daily Drilling Reports of Mayfield-Smith Drilling, Inc.

Edgar E. Smith
Edgar E. Smith

State of Kansas)
) SS
County of Sedgwick)

Subscribed and sworn to before me this 22nd day of April, 1964, a Notary Public in and for Sedgwick County, Kansas.

Mary Karen Blume
Mary Karen Blume

My Commission Expires: June 14, 1964

