


Give All Information Completely
Make Required Affidavit
Mail or Deliver Report to:
Conservation Division
State Corporation Commission
211 No. Broadway
Wichita, Kansas

WELL PLUGGING RECORD

NORTH

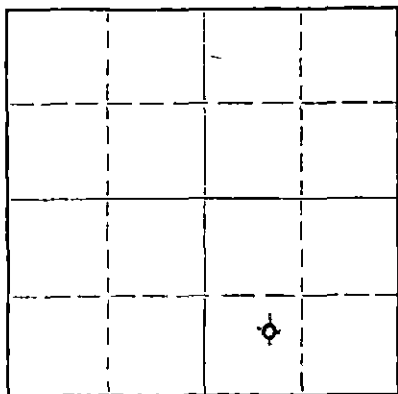

Locate well correctly on above Section Plat

BARTON

County. Sec. 8 Twp. 19S Rge. (E) 11 (W)

Location as "NE/CNWxSWx" or footage from lines. NE SW SE
Lease Owner. REX & MORRIS, ET AL
Lease Name. AHRENS Well No. 1
Office Address. P. O. BOX 334, EL DORADO, KANSAS 67042
Character of Well (completed as Oil, Gas or Dry Hole) DRY HOLE
Date well completed 18 APRIL 19 65
Application for plugging filed 18 APRIL 19 65
Application for plugging approved 18 APRIL 19 65
Plugging commenced 18 APRIL 19 65
Plugging completed 18 APRIL 19 65
Reason for abandonment of well or producing formation DRY HOLE

If a producing well is abandoned, date of last production. NONE 19
Was permission obtained from the Conservation Division or its agents before plugging was commenced? YES

Name of Conservation Agent who supervised plugging of this well DONALD TRUAN
Producing formation NONE Depth to top _____ Bottom _____ Total Depth of Well 3425 Feet
Show depth and thickness of all water, oil and gas formations.

OIL, GAS OR WATER RECORDS

CASING RECORD

FORMATION	CONTENT	FROM	TO	SIZE	PUT IN	PULLED OUT
SURFACE HOLE	WATER	SURFACE	217'RB	8 5/8" OD	212.34'	LEFT IN

Describe in detail the manner in which the well was plugged, indicating where the mud fluid was placed and the method or methods used in introducing it into the hole. If cement or other plugs were used, state the character of same and depth placed, from _____ feet to _____ feet for each plug set.

FILLED HOLE WITH HEAVY DRILLING MUD, PUT IN PLUG, PUMPED IN 100 SACKS CEMENT WITH SERVICE TRUCK, MAXIMUM PRESSURE 100 PSI.

RECEIVED
STATE CORPORATION COMMISSION

MAY 6 1965

CONSERVATION DIVISION
Wichita, Kansas

5-6-65

(If additional description is necessary, use BACK of this sheet)

Name of Plugging Contractor REX & MORRIS DRILLING COMPANY
Address P. O. BOX 334, EL DORADO, KANSAS 67042

STATE OF KANSAS, COUNTY OF BUTLER, ss.
A. H. FISHER

(employee of owner) or (owner or operator) of the above-described well, being first duly sworn on oath, says: That I have knowledge of the facts, statements, and matters herein contained and the log of the above-described well as filed and that the same are true and correct. So help me God.

(Signature) A. H. Fisher
P. O. BOX 334, EL DORADO, KANSAS 67042
(Address)

SUBSCRIBED AND SWORN TO before me this 4TH day of MAY, 19 65

My commission expires 8 AUGUST 1966
Elizabeth Deschner Notary Public.

15.009 30230.00.00

AURENS #1

Rex & Morris, et al.

Elevation 1781' RB
1776' GL

Total Depth: 3425'
Contractor: Rex & Morris
Commenced: 4-12-65
Completed: 4-18-65
Initial Prod.: D & A

Location: NE SW SE
Section 8-19E-11W
Barton County, Kansas

Casing Record:
8 5/8" OD @ 217' w/175 Sacks

FORMATION	DEPTH
Surface Hole	217'
Shale	590'
Anhydrite	605'
Shale	855'
Shale and Shells and Salt	1350'
Lime and Shale	2788'
Lime	2939'
Shale and Lime	3078'
Lime - Lansing - K.C.	3308'
Lime and Shale	3340'
Conglomerate Shale	3361'
Conglomerate Sand	3398'
Lime - Arbuckle RTD	3425'

RECEIVED
STATE CORPORATION COMMISSION

MAY 6 1965

CONSERVATION DIVISION
Wichita, Kansas

I hereby certify the foregoing statements are true and correct to the best of my knowledge and belief.

Rex & Morris Drilling Company

By _____

A. H. Fisher
A. H. Fisher

STATE OF KANSAS
COUNTY OF BUTLER, SS.

Subscribed and sworn to before me, a Notary Public, this 4th day of May, 1965.

Elizabeth Beschmar
Elizabeth Beschmar, Notary Public

My commission expires: August 8, 1966.