

STATE OF KANSAS  
 STATE CORPORATION COMMISSION


Give All Information Completely  
 Make Required Affidavit  
 Mail or Deliver Report to:  
 Conservation Division  
 State Corporation Commission  
 800 Bitting Building  
 Wichita, Kansas

OR

**FORMATION PLUGGING RECORD**

Strike out upper line  
 when reporting plug-  
 ging off formations.

NORTH

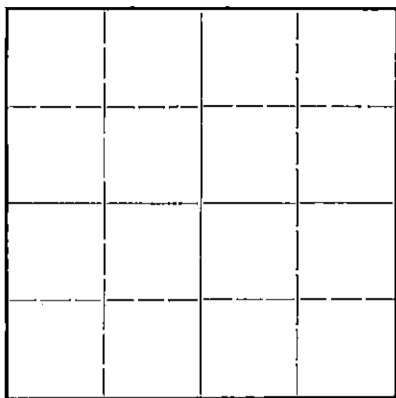

Locate well correctly on above  
 Section Plat

Barton County. Sec. 18 Twp. 18S Rge. (E) 14 (W)  
 Location as "NE $\frac{1}{4}$ NW $\frac{1}{4}$ SW $\frac{1}{4}$ " or footage from lines SW-SW-SW  
 Lease Owner Helmerich & Payne, Inc.  
 Lease Name B. J. Schneider Well No. 1  
 Office Address 415 Philtower Bldg., Tulsa 3, Oklahoma  
 Character of Well (completed as Oil, Gas or Dry Hole) Dry  
 Date well completed 1-24-45 19\_\_\_\_  
 Application for plugging filed 1-24-45 19\_\_\_\_  
 Application for plugging approved 1-24-45 19\_\_\_\_  
 Plugging commenced 1-24-45 19\_\_\_\_  
 Plugging completed 1-24-45 19\_\_\_\_  
 Reason for abandonment of well or producing formation Dry Hole

If a producing well is abandoned, date of last production \_\_\_\_\_ 19\_\_\_\_  
 Was permission obtained from the Conservation Division or its agents before plugging was com-  
 menced? Yes

Name of Conservation Agent who supervised plugging of this well \_\_\_\_\_  
 Producing formation None Depth to top \_\_\_\_\_ Bottom \_\_\_\_\_ Total Depth of Well 3,731 Feet  
 Show depth and thickness of all water, oil and gas formations.


**OIL, GAS OR WATER RECORDS**

**CASING RECORD**

Formation	Content	From	To	Size	Put In	Pulled Out
<u>Arbuckle Lime</u>	<u>Dry</u>	<u>3524</u>	<u>3726</u>	<u>10-3/4</u>	<u>941'</u>	<u>None</u>
<u>Reagan Sand</u>	<u>Dry</u>	<u>3726</u>	<u>3731</u>			

Describe in detail the manner in which the well was plugged, indicating where the mud fluid was placed and the method or methods used in introducing it into the hold. If cement or other plugs were used, state the character of same and depth placed, from \_\_\_\_\_ feet to \_\_\_\_\_ feet for each plug set.

Filled with heavy mud from 3731' to 941'. Set bridge at 941. Run 15 sacks of cement. Filled hole from 911' to 25' with heavy mud. Hole bridged at 25'. 10 Sacks of cement spotted at 25' filling to bottom of cellar.

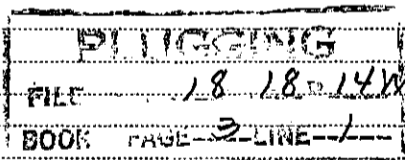

1-30-45

(If additional description is necessary, use BACK of this sheet)

Correspondence regarding this well should be addressed to Helmerich & Payne, Inc.  
 Address 415 Philtower Bldg., Tulsa 3, Oklahoma

STATE OF OKLAHOMA COUNTY OF TULSA

Harry Saye (employee of owner) or (owner of property) of the above-described well, being first duly sworn on oath, says: That I have knowledge of the facts, statements, and matters herein contained and the log of the above-described well as filed and that the same are true and correct. So help me God.

(Signature) Harry Saye Prod. Supt.  
415 Philtower Bldg., Tulsa 3, Oklahoma  
 (Address)

SUBSCRIBED AND SWORN to before me this 29 day of January 1945

My commission expires 7-22-47

Shirley Steffen  
 Notary Public.

15,009.01323.00.00

Schneider #1  
SW/4 SW/4 Section 18-18S-14W  
Barton County, Kansas  
Helmerich & Payne, Inc.

Commenced: December 20, 1944  
Completed: January 24, 1945

Surface soil	0	40
Shell and surface soil	40	300
Clay and lime shells	300	335
Shale and shells	335	520
Sand	520	560
Shale	560	590
Sand	590	635
Shale	635	665
Sand, stks of shale	665	691
Sand, stks and red bed	691	710
Sand, red bed and shale	710	750
Red bed and shale	750	815
Shale and sand stks	815	885
Shale	885	1025
Red bed and shale	1025	1071
Red bed	1071	1081
Anhydrite	1081	1478
Shale and shells	1478	1692
Shale and salt	1692	1765
Shale, shells	1765	1785
Shale and red bed	1785	1815
Shale, sand and lime	1815	1823
Sand	1823	1940
Sandy lime	1940	2050
Shale, lime shells	2050	2750
Sandy lime and shale	2750	2876
Broken lime	2876	2948
Shale and broken lime	2948	2962
Lime, broken	2962	3096
Lime and shale	3096	3158
Lime	3158	3280
Shale and lime stks	3280	3278
Lime	3278	3297
Cherty lime	3297	3369
Lime, soft and shale	3369	3412
Lime	3412	3485
Shale and lime stks	3485	3500
Lime and shale	3500	3524
Conglomerate	3524	3530
Arbuckle lime	3530	3560
Lime	3560	3589
Arbuckle lime	3589	3634
Lime	3634	3725
Arbuckle lime	3725	3726
Sand	3726	3731
TOTAL DEPTH	3731	

CASING RECORD

10-3/4" Casing set at 941' and cemented with 500 sacks of cement.

STATE OF OKLAHOMA )  
                          )  
                          )  
COUNTY OF TULSA )

I hereby affirm that the above and foregoing is a true and correct copy of the log of our Schneider Well #1, located in the Southwest Quarter of the Southwest Quarter of Section 18, Township 10 South, Range 14 West, Barton County, Kansas.

HELMERICH & PAYNE, INC.  
By William Howard Hunt  
Treasurer

Subscribed and sworn to before me, a Notary Public, this 30th day of January, 1945.

Paul Suffer  
Notary Public

My commission expires July 23rd, 1947.

FILED  
18-18-14W  
3