


WELL PLUGGING RECORD

Give All Information Completely
Make Required Affidavit
Mail or Deliver Report to:
Conservation Division
State Corporation Commission
800 Biltmore Building
Wichita, Kansas

NORTH

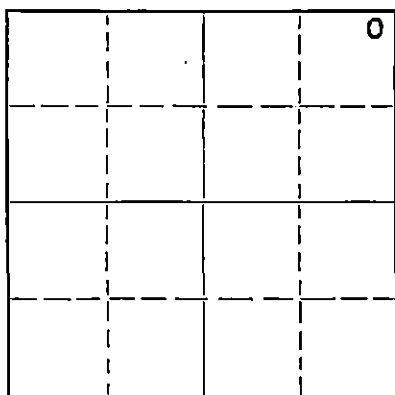

Locate well correctly on above
Section Plat

Barton County, Sec. 3 Twp. 18S Rge. XXX(14) 14 (W)
Location as "NE/CNW $\frac{1}{4}$ /SW $\frac{1}{4}$ " or footage from lines NE NE NE
Lease Owner Murphy Oil Company of Oklahoma, Inc.
Lease Name Eveleigh "B" Well No. 1
Office Address 1604 Philtower Building, Tulsa, Oklahoma
Character of Well (completed as Oil, Gas or Dry Hole) DRY
Date well completed February 28 1953
Application for plugging filed March 11 1953
Application for plugging approved March 11 1953
Plugging commenced March 12 1953
Plugging completed March 12 1953
Reason for abandonment of well or producing formation Dry Hole

If a producing well is abandoned, date of last production 19
Was permission obtained from the Conservation Division or its agents before plugging was commenced? Yes

Name of Conservation Agent who supervised plugging of this well C. D. Stough
Producing formation None Depth to top Bottom Total Depth of Well 3403 Feet
Show depth and thickness of all water, oil and gas formations.

OIL, GAS OR WATER RECORDS

CASING RECORD

Formation	Content	From	To	Size	Put In	Pulled Out
				8-5/8"	854'	None
				4-1/2"	3388'	2400'

Describe in detail the manner in which the well was plugged, indicating where the mud fluid was placed and the method or methods used in introducing it into the hole. If cement or other plugs were used, state the character of same and depth placed, from feet to feet for each plug set.

Plugged back with crushed rock from 3403' to 3380'
Dumped 3 sax cement at 3380 with dump bailer. Top of cement 3350'. Filled hole with mud to 250', set rock bridge, dumped 20 sax cement, top of cement 190'. Filled hole with mud to 35', set rock bridge, dumped 10 sax cement for cap.

WSD
3-17-53

Name of Plugging Contractor Earl Miller
Address Great Bend, Kansas

STATE OF Oklahoma COUNTY OF Tulsa, ss.
Roger R. Patton (employee of owner) or (owner or operator) of the above-described well, being first duly sworn on oath, says: That I have knowledge of the facts, statements, and matters herein contained and the log of the above-described well as filed and that the same are true and correct. So help me God.

(Signature) Roger R. Patton, Geol.
1604 Philtower Building, Tulsa, Oklahoma
(Address)

SUBSCRIBED AND SWORN to before me this 16th day of March, 1953.
Verlin Stover
Notary Public.

My commission expires Dec. 15, 1955

23-8390-s 6-51-20M
PLUGGING
FILE REC 3 T 18 R 1426
BOOK PAGE 84 LINE 34

EVELEIGH B NO. 1

NE NE NE Section 3-18S-14W
Barton County, Kansas
Murphy Oil Company

8-5/8" O.D. casing cemented at 849'
4-1/2" O.D. casing cemented at 3388'

Drilling commenced 2- 5-53
Drilling completed 2-19-53

FROM	TO	FORMATION	REMARKS
0'	275'	Surface rock	
275	315	Pyrite & shells	
315	410	Shale & shells	
410	515	Dakota Sand & shells	
515	580	Sand	
580	820	Red bed	
820	849	Chalk & Anhydrite	8-5/8" O.D. casing cemented
849	880	Anhydrite	with 450 sacks cement at 849'
880	1050	Red bed	
1050	1530	Shale & shells	
1530	1725	Shale & lime	
1725	2100	Lime & shale	
2100	2220	Shale & lime	
2220	2755	Shale	
2755	2850	Shale & lime	
2850	3045	Lime	
3045	3130	Lime & shale	
3130	3157	Shale & lime	
3157	3187	Lime & shale	
3187	3230	Lime	
3230	3250	Lime & shale	
3250	3300	Lime	
3300	3345	Lime & shale	
3345	3392	Lime	4-1/2" O.D. casing cemented with 150 sacks cement at 3392'
T.D.	3392'		

This is a true copy of the driller's log as shown on the drilling tickets.

BARBOUR DRILLING COMPANY

BY: L. W. Ribey

Subscribed and sworn to before me on this 2nd day of March, 1953

My commission expires: July 27, 1953.

Mary Jane Burt
Notary Public