

STATE OF KANSAS
STATE CORPORATION COMMISSION

15. 009. 00370. 00.00

WELL PLUGGING RECORD

Give All Information Completely
Make Required Affidavit
Mail or Deliver Report to:
Conservation Division
State Corporation Commission
806 Bittling Building
Wichita, Kansas

Barton County, Sec. 12 Twp. 18 Rge. 11 (E) (W)

Location as "NE/CNW/SW" or footage from lines SW/4

Lease Owner National Cooperative Refinery Association

Lease Name Sadie Smith Well No. 2

Office Address Wichita, Kansas

Character of Well (completed as Oil, Gas or Dry Hole) Dry Hole

Date well completed 19 51

Application for plugging filed April 7 19 51

Application for plugging approved April 7 19 51


Plugging commenced April 8 19 51

Plugging completed April 8 19 51

Reason for abandonment of well or producing formation Dry Hole

If a producing well is abandoned, date of last production Non-Producing 19

Was permission obtained from the Conservation Division or its agents before plugging was commenced? Yes

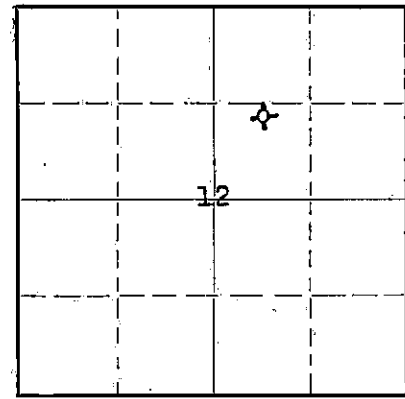

Locate well correctly on above Section Flat

Name of Conservation Agent who supervised plugging of this well V. D. Stough

Producing formation None Present Depth to top - Bottom Total Depth of Well 3305 Feet

Show depth and thickness of all water, oil and gas formations.

OIL, GAS OR WATER RECORDS

CASING RECORD

Formation	Content	From	To	Size	Put In	Pulled Out
All zones proved to be non-productive				8-5/8"	218'	None (Cemented)

Describe in detail the manner in which the well was plugged, indicating where the mud fluid was placed and the method or methods used in introducing it into the hole. If cement or other plugs were used, state the character of same and depth placed, from _____ feet to _____ feet for each plug set.

Set rock bridge @ 3305'. Dump 2 sacks crushed rock on top of bridge filled hole to 3287 from 3305 w/10 sacks cement. Filled hole with heavy mud to 218'. Bottom of surface pipe set plug and dumped 10 sacks cement on top of plug. Filled hole with heavy rotary mud to within 10 feet of base of cellar. Ran 10 sacks cement. Job complete.

RECEIVED
STATE CORPORATION COMMISSION
APR 30 1951
CONSERVATION DIVISION
Wichita, Kansas

4-30-51

(If additional description is necessary, use BACK of this sheet)

Correspondence regarding this well should be addressed to National Cooperative Refinery Association
Address 820 Union National Bank Bldg. Wichita, Kansas

STATE OF Kansas, COUNTY OF Sedgwick, ss.
W. Jean La Coss (employee of owner) or (owner or operator) of the above-described well,
being first duly sworn on oath, says: That I have knowledge of the facts, statements, and matters herein contained and the log of the above-described well as filed and that the same are true and correct. So help me God.

(Signature) *W. Jean La Coss*

(Address)

SUBSCRIBED AND SWORN to before me this 26th day of April, 19 51

I. A. Lange
I. A. Lange Notary Public.

My commission expires February 20, 1953

22-5133-s 9-48-10M

PLUGGING
FILE SEC 12 T 18 R 11 W
BOOK PAGE 72 LINE 26

15.009.00270.00.00

NATIONAL COOPERATIVE REFINERY ASS'N.

WICHITA, KANSAS

Well: Sadie Smith #2

Approx. Center of the North Line of SW/4 of NE/4 Section 12-18-11 Barton County, Kansas

Commenced RD: 3/27/51
Completed RD: 4/5/51
Total Depth : 3305'

Elevation:
Initial Prod:
Contractor: Brunson Drlg. Co.

Casing: 218' 8 5/8" O.D.

STRATA	DEPTH
Surface soil & clay	25
Sand, Shells & Gravel	73
Shale	87
Sand	109
Shale & Shells	218
Shale	275
Redbeds	560
Anhydrite	590
Redbeds & Shale	900
Shale & Shells	1210
Shale & Lime	1425
Broken Lime	1735
Lime	1945
Shale & Lime	2070
Lime & Shale	2785
Lime	2830
Lime & Shale	2990
Lime	3065
Lime & Shale	5140
Lime	3273
Lime & Shale	3287
Lime	3302
Lime, Shale & Sand	3305
Total Depth	3305

I hereby certify that the above is a true and correct log of said well as reflected by the daily drilling reports.

BRUNSON DRILLING COMPANY, INC.
By

Ralph B. McLaughlin
Ralph B. McLaughlin

Signed and sworn to in my presence this 10th day of April, 1951, by R. B. McLaughlin, Asst. Secretary of the Brunson Drilling Company, Inc., a corporation in the State of Kansas.

RECEIVED
STATE COMMISSIONER OF GEOL.

APR 13 1951

COMMISSIONER OF GEOL.
Wichita, Kansas

Edwina C. Combs
Notary Public

My commission expires September 23, 1953.

PLUGGING
FILE SEC. 18 T. 18 R. 11 W.
BOOK PAGE 72 LINE 56