


STATE OF KANSAS  
STATE CORPORATION COMMISSION

15.009.00258.00.00

Give All Information Completely  
Make Required Affidavit  
Mail or Deliver Report to:  
Conservation Division  
State Corporation Commission  
211 No. Broadway  
Wichita, Kansas

WELL PLUGGING RECORD

NORTH

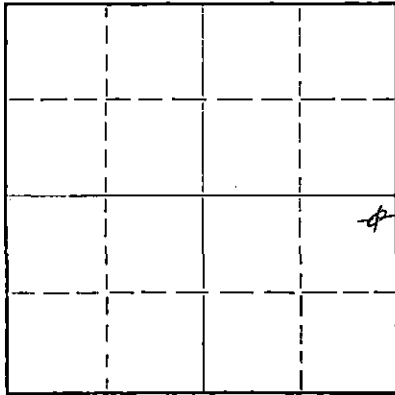

Locate well correctly on above  
Section Plat

Barton County, Sec. 36 Twp. 20 Rge. 13 (E) (W)  
Location as "NE/CNWxSWx" or footage from lines. NE SE SE  
Lease Owner Virginia Drilling Co., Inc.  
Lease Name Lomnon A Well No. 1  
Office Address 712 Brown Bldg-Wichita 2, Kansas  
Character of Well (completed as Oil, Gas or Dry Hole) dry hole  
Date well completed 7-14-59 19  
Application for plugging filed 7-14-59 19  
Application for plugging approved 7-14-59 19  
Plugging commenced 7-15-59 19  
Plugging completed 7-15-59 19  
Reason for abandonment of well or producing formation \_\_\_\_\_

If a producing well is abandoned, date of last production \_\_\_\_\_ 19\_\_\_\_  
Was permission obtained from the Conservation Division or its agents before plugging was commenced? yes

Name of Conservation Agent who supervised plugging of this well Donald Truan  
Producing formation \_\_\_\_\_ Depth to top \_\_\_\_\_ Bottom \_\_\_\_\_ Total Depth of Well 3542 Feet  
Show depth and thickness of all water, oil and gas formations.

OIL, GAS OR WATER RECORDS

CASING RECORD

FORMATION	CONTENT	FROM	TO	SIZE	PUT IN	PULLED OUT
		0	250	8 5/8"	250	none

Describe in detail the manner in which the well was plugged, indicating where the mud fluid was placed and the method or methods used in introducing it into the hole. If cement or other plugs were used, state the character of same and depth placed, from \_\_\_\_\_ feet to \_\_\_\_\_ feet for each plug set.

Mudded to 240 ft - set plug w/ 25 sx cement 1/4 sx hulls  
" 40 ft - set plug w/ 10 sx cement 1/2 sx hulls

RECEIVED  
STATE CORPORATION COMMISSION

JUL 29 1959

CONSERVATION DIVISION  
Wichita, Kansas

(If additional description is necessary, use BACK of this sheet)  
Name of Plugging Contractor Virginia Drilling Co., Inc.  
Address 712 Brown Bldg.-Wichita 2, Kansas

STATE OF Kansas COUNTY OF Sedgwick, ss.  
S. A. Murphy (employee of owner) or (owner or operator) of the above-described well, being first duly sworn on oath, says: That I have knowledge of the facts, statements, and matters herein contained and the log of the above-described well as filed and that the same are true and correct. So help me God.

(Signature) [Signature]  
712 Brown Bldg-Wichita 2, Kansas  
(Address)

SUBSCRIBED AND SWORN TO before me this 28th day of July, 1959

My commission expires Febr. 5, 1961. [Signature] Notary Public.

PLUGGING  
FILE SEC. 36 T. 20 R. 13W  
BOOK PAGE 55 LINE 45

5.009 00258 00.00

LONNON A#1 - NE SE SE Section 36-20-13 Barton County, Kansas  
Company - Virginia Drilling Co., Inc.  
Contractor - same  
Commenced - July 2, 1959  
Completed - July 15, 1959  
Elevation - 1862 KB  
Total depth - 3542

Dry Hole  
8 5/8" set at 250 ft  
w/220 sx cem. 3% gel 2%cc

FORMATION	DEPTH	TOPS:
Sand	0 - 195	
Shale & sand	195 - 250	
Redbed	250 - 678	
Anhydrite	678 - 706	
Shale-shells	706 - 1110	
Shale-lime	1110 - 1510	
Lime	1510 - 1630	3095 - Heebner shale
Lime-shale	1630 - 2070	3135 - Douglass shale
Shale-shells	2070 - 2310	3219 - Iatan lime
Shale	2310 - 2550	3232 - Lansing
Lime-shale	2550 - 2620	3454 - Conglomerate
Shale-shells	2620 - 2730	3489 - Weathered Arb.
Lime-shale	2730 - 2910	3504 - Arbuckle
Lime	2910 - 2965	
Lime-shale	2965 - 3030	
Lime	3030 - 3130	
Lime-shale	3130 - 3205	
Lime	3205 - 3233	
Lime-shale	3233 - 3360	
Lime	3360 - 3435	
Lime-shale	3435 - 3485	
Conglomerate	3485 - 3489	
Arbuckle	3489 - 3542 TD	

*S. A. Murphy*  
S. A. Murphy

Subscribed and sworn to before me, a Notary Public  
this 28th day of July, 1959.

*W. Duke Hawley*  
Notary Public

My commission expires: Febr. 5, 1961.

RECEIVED  
STATE CORPORATION COMMISSION

JUL 29 1959  
CONSERVATION DIVISION  
Wichita, Kansas

PLUGGING  
FILE - SEC 36 T. 20 R. 13 W  
BOOK PAGE 55 LINE 45