

Give All Information Completely
Make Required Affidavit
Mail or Deliver Report to:
Conservation Division
State Corporation Commission
212 No. Market
Wichita, Kansas

WELL PLUGGING RECORD

BARTON

County. Sec. 32 Twp. 20S Rge. 12 (E) W (W)

Location as "NE/CNW/SW" or footage from lines SW SW SE

Lease Owner LLOYD K PARRISH JR.

Lease Name BROWN #4 Well No.

Office Address 714 FOURTH NATIONAL BANK BLDG.

Character of Well (completed as Oil, Gas or Dry Hole) DRY HOLE

Date well completed JULY 22, 1969 19

Application for plugging filed JULY 22, 1969 19

Application for plugging approved JULY 22, 1969 19


Plugging commenced JULY 22, 1969 19

Plugging completed JULY 22, 1969 19

Reason for abandonment of well or producing formation TOO LOW STRUCTURALLY

If a producing well is abandoned, date of last production 19

Was permission obtained from the Conservation Division or its agents before plugging was commenced? YES

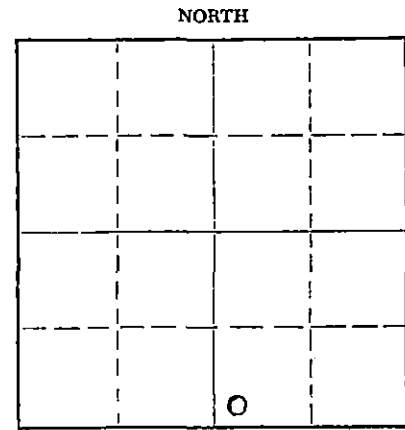

Locate well correctly on above Section Plat

Name of Conservation Agent who supervised plugging of this well DONALD TRUAN,

Producing formation _____ Depth to top _____ Bottom _____ Total Depth of Well 3510 Feet

Show depth and thickness of all water, oil and gas formations.

OIL, GAS OR WATER RECORDS

CASING RECORD

FORMATION	CONTENT	FROM	TO	SIZE	PUT IN	PULLED OUT
				8-5/8"	277.84'	NONE

Describe in detail the manner in which the well was plugged, indicating where the mud fluid was placed and the method or methods used in introducing it into the hole. If cement or other plugs were used, state the character of same and depth placed, from _____ feet to _____ feet for each plug set.

FILLED WITH HEAVY MUD TO 240'. SET PLUG.
PUT IN 45 SX CEMENT. FILLED WITH HEAVY
MUD TO 240'. SET PLUG. PUT IN 25 SACKS
CEMENT. FILLED WITH HEAVY MUD UP TO
40'. SET PLUG. FILLED TO TOP WITH 1/2
SACK HULLS AND 10SACKS CEMENT.

RECEIVED
STATE CORPORATION COMMISSION
JUL 31 1969
CONSERVATION DIVISION
Wichita, Kansas

Name of Plugging Contractor C-G DRILLING CO.
Address 1107 UNION NATIONAL BLDG., WICHITA, KANSAS 67202


STATE OF KANSAS, COUNTY OF SEDGWICK, ss.
G F GALLOWAY (employee of owner) or (owner or operator) of the above-described

well, being first duly sworn on oath, says: That I have knowledge of the facts, statements, and matters herein contained and the log of the above-described well as filed and that the same are true and correct. So help me God.

(Signature) G F GALLOWAY 1107 UNION NATIONAL BLDG.
(Address)

Subscribed and sworn to before me this 28th day of JULY, 1969

My commission expires DEC 7, 1971
Phyllis Buchanan
PHYLLIS BUCHANAN Notary Public.

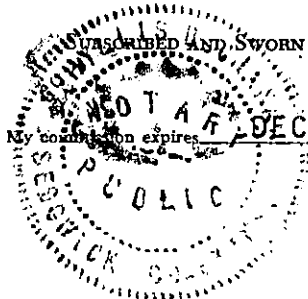

W E L L L O G

OPERATOR: LLOYD K PARRISH
 WELL NAME: BROWN #4 LOCATION: SW SW SE SEC 32-20S-12W
 COUNTY: BARTON STATE: KANSAS
 WELL COMMENCED: JULY 14, 1969 WELL COMPLETED: JULY 22, 1969
 ELEVATION: 1853 KB TOTAL DEPTH: 3510'
 PRODUCTION: D & A RIG NO: 1
 CASING - 8-5/8": 7 jts, 277.84' W/260 SX QUICKSET
 5-1/2": _____

ALL MEASUREMENTS TAKEN FROM THE TOP OF ROTARY BUSHING:

FROM	TO	FORMATION	DEVIATION FROM VERTICAL	REMARKS:
0	217	SAND	3/4° 500'	DST #1 3210-3260'
276	637	RED BED	3/4° 1100'	DST #2 3470-3490'
637	668	ANHYDRITE	1° 1600'	DST #3 3490-3510'
668	705	SHALE & SHELLS	1° 2500'	
705	1520	SHALE		
1520	3040	LIME & SHALE		
3040	3490	LIME		
3490	3500	ARBUCKLE		

RECEIVED
 STATE CORPORATION COMMISSION
 JUL 31 1969
 CONSERVATION DIVISION
 Wichita, Kansas

STATE OF KANSAS)
 COUNTY OF SEDGWICK) SS:

The undersigned hereby certifies that to the best of his knowledge and belief, the above facts are true and correct.

C-G DRILLING CO.

By G F Galloway

G F GALLOWAY

SUBSCRIBED AND SWORN TO, BEFORE ME, This 28th day of JULY, 1969.

EXP. DEC. 7, 1971

Phyllis Buchanan
 PHYLLIS BUCHANAN - NOTARY PUBLIC

