

WELL PLUGGING RECORD

Give All Information Completely  
Make Required Affidavit  
Mail or Deliver Report to:  
Conservation Division  
State Corporation Commission  
211 North Broadway  
Wichita, Kansas

Barton County, Sec. 30 Twp. 20S Rge. (E) 12 (W)

Location as "NE/CNW/SW" or footage from lines NW NE NW

Lease Owner Bergman Oil Company

Lease Name Welsh Well No. 2

Office Address 425 Union Center Bldg., Wichita, Kansas 67202

Character of Well (completed as Oil, Gas or Dry Hole) dry hole

Date well completed May 14 1965

Application for plugging filed May 14 1965

Application for plugging approved May 14 1965


Plugging commenced May 14 1965

Plugging completed May 14 1965

Reason for abandonment of well or producing formation dry hole

If a producing well is abandoned, date of last production 19

Was permission obtained from the Conservation Division or its agents before plugging was commenced? yes

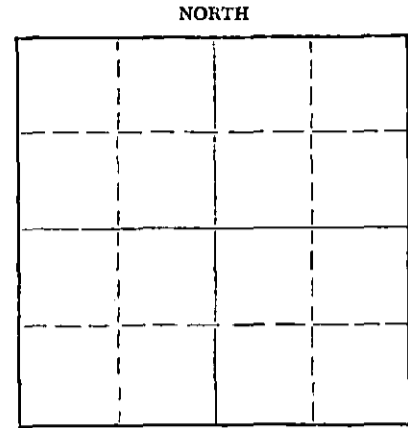

Locate well correctly on above Section Plat

Name of Conservation Agent who supervised plugging of this well Donald Truan

Producing formation \_\_\_\_\_ Depth to top \_\_\_\_\_ Bottom \_\_\_\_\_ Total Depth of Well 3541 Feet

Show depth and thickness of all water, oil and gas formations.

OIL, GAS OR WATER RECORDS

CASING RECORD

FORMATION	CONTENT	FROM	TO	SIZE	PUT IN	PULLED OUT
Sand & Shale		0	341	8-5/8	341	none

Describe in detail the manner in which the well was plugged, indicating where the mud fluid was placed and the method or methods used in introducing it into the hole. If cement or other plugs were used, state the character of same and depth placed, from top feet to bottom feet for each plug set.

Set first plug at 215 feet with 1/2 sack hulls on top of plug.  
Set second plug at 35 feet with 12 sacks cement and hulls on top of plug.

RECEIVED  
STATE CORPORATION COMMISSION

JUN 7 1965

CONSERVATION DIVISION  
Wichita, Kansas

6-7-65

(If additional description is necessary, use BACK of this sheet)  
Name of Plugging Contractor Bergman Drilling, Inc. #507  
Address 425 Union Center Bldg., Wichita, Kansas

STATE OF KANSAS, COUNTY OF SEDGWICK, ss.  
I, Harold Bergman (employer or owner) or (owner or operator) of the above-described well, being first duly sworn on oath, says: That I have knowledge of the facts, statements, and matters herein contained and the log of the above-described well as filed and that the same are true and correct. So help me God.

(Signature) Harold Bergman  
425 Union Center Bldg., Wichita, Kansas 67202  
(Address)

SUBSCRIBED AND SWORN TO before me this 3rd day of June, 19 65

My commission expires August 2, 1966

Norman Johnson  
Notary Public.

15.009.30075.00.00

DRILLERS' LOG

WELSH #2 = NW NE NW  
Section 30-20S-12W  
Barton County, Kansas

Date Commenced: May 7, 1965  
Date Completed: May 14, 1965

Casing record:

341 feet 8-5/8" with 250 sacks.

0	-	200	Sand
200	-	215	Shale
215	-	339	Shale
339	-	865	Shale and Red Bed
865	-	1460	Shale and Shells
1460	-	1520	Shale and Shells
1520	-	1685	Lime and Shale
1685	-	1840	Lime and Shale
1840	-	2075	Lime and Shale
2075	-	2230	Lime and Shale
2230	-	2345	Shale and Shells
2345	-	2600	Shale and Lime
2600	-	2745	Lime and Shale
2745	-	2870	Lime and Shale
2870	-	2935	Lime and Shale
2935	-	3010	Lime
3010	-	3050	Lime
3050	-	3190	Lime
3190	-	3285	Lime
3285	-	3290	Lime
3290	-	3370	Lime
3370	-	3445	Lime
3445	-	3510	Lime and Shale
3510	-	3520	Lime
3520	-	3530	Lime
3530	-	3541	Arbuckle
3541			Rotary Total Depth

RECEIVED  
STATE CORPORATION COMMISSION  
JUN 7 1965  
CONSERVATION DIVISION  
Wichita, Kansas

A F F I D A V I T

STATE OF KANSAS )  
                  ) SS.  
COUNTY OF SEDGWICK)

I, do swear that the statements and matter herein contained are true to the best of my knowledge.

BERGMAN OIL COMPANY

*Walter Bergman*

Subscribed and sworn to before me this 3rd day of June, 1965.

*Harold J. Jackson*  
Notary Public

My Commission Expires:

August 2, 1966