

15.009.00040.00.00

WELL LOG

Perry Bryant No. 1


<u>From</u>	<u>To</u>	
0	100	Surface Clay & Sand
100	133	Sand
133	252	Red Bed & Clay
252	780	Red Bed
780	820	Anhydrite
820	1585	Shale & shells
1585	1804	Lime & Shale
1804	1822	Sand
1822	2780	Lime & Shale
2780	3014	Broken Lime
3014	3018	Hebner Shale
3018	3149	Lime
3149	3165	Brown Lime
3165	3385	Lansing Kansas City Lime
3385	3414	Shale & Rewashed Arbuckle
3414	3451	Arbuckle Lime Dry.

RECEIVED
MINERAL COMMISSION

AUG 1 1952
PLUGGING
DIVISION
FILE SEC-27T-2-R-12
BOOK PAGE 32 LINE 9



15 009. 00040. 00. 00

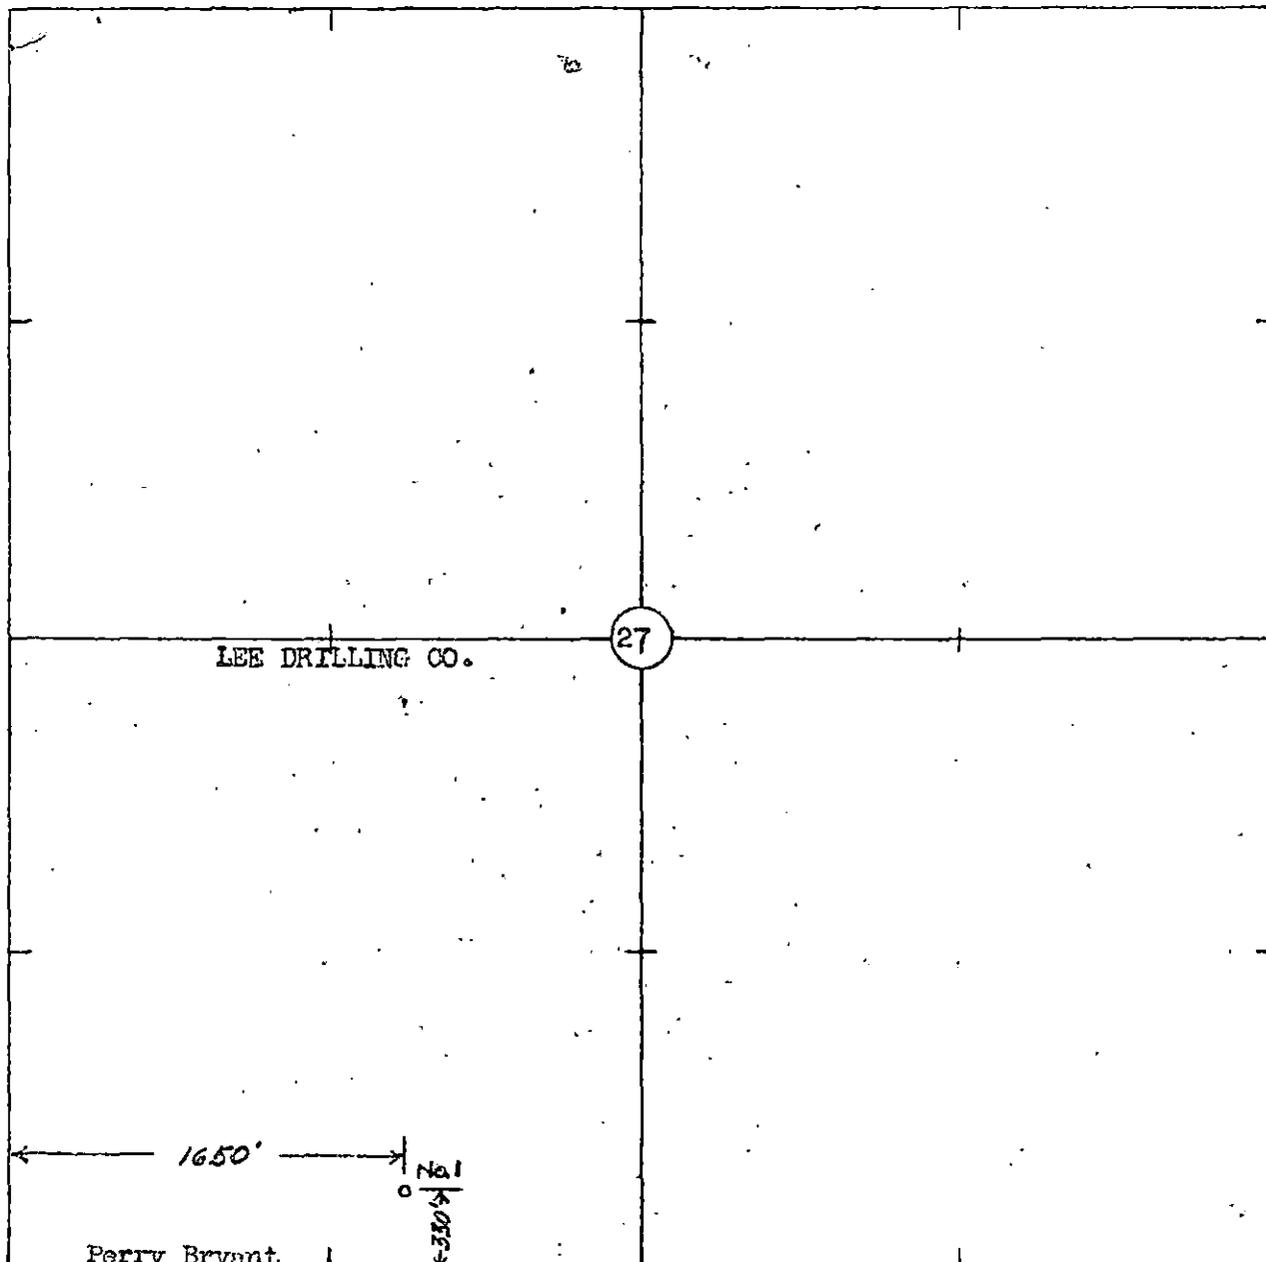

THE ABOVE IS A TRUE AND ACCURATE SURVEY LOCATING WELL NO. 1
 ON THE Perry Bryant LEASE Barton COUNTY, KANSAS 1650 feet
 FROM THE West LINE AND 330 feet FROM THE South LINE OF
 THE SW/4 OF SECTION 27 - TOWNSHIP 20S - RANGE 12W MADE BY ME
 THIS 12 DAY OF July 1952.

SIGNED Joan M. Rice

NOTE: Ground elevation at P. Bryant No. 1 is approx. 4.2' lower than ground at Longrehr No. 2.

RECEIVED

STATE CORPORATION COMM

AUG 1 1952

CONSERVATION DIVISION
Wichita, Kansas

OWN	IMR	7/12/52	LEE DRILLING COMPANY Perry Bryant No. 1 Sec. 27-20S-12W
			RICE ENGINEERING CO. CHASE, KANSAS

SCALE 1" = 800'
DWG. NO. A