

STATE OF KANSAS
STATE CORPORATION COMMISSION

WELL PLUGGING RECORD


Give All Information Completely
Make Required Affidavit
Mail or Deliver Report to:
Conservation Division
State Corporation Commission
800 Bittling Building
Wichita, Kansas

OR

FORMATION PLUGGING RECORD

Strike out upper line
when reporting plug-
ging off formations.

Barton County. Sec. 14 Twp. 16 Rge. 12 (E) (W)
Location as "NE $\frac{1}{4}$ NW $\frac{1}{4}$ SW $\frac{1}{4}$ " or footage from lines. NE 1/4 Sec 14 T16 R12

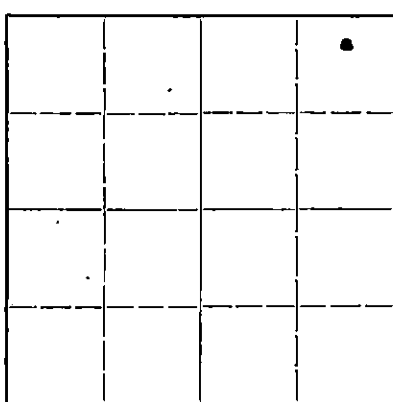

Locate well correctly on above
Section Plat

Lease Owner: H. E. May
Lease Name: Feltz J
Office Address: Salina Kansas 429
Well No. 6 P.O. Box
Character of Well (completed as Oil, Gas or Dry Hole) Dry hole
Date well completed: 2 16 1946
Application for plugging filed: 2 16 1946
Application for plugging approved: 2 16 1946
Plugging commenced: 2-16 1946
Plugging completed: 2-16 1946
Reason for abandonment of well or producing formation: Dry

If a producing well is abandoned, date of last production.....19.....
Was permission obtained from the Conservation Division or its agents before plugging was com-
menced? yes

Name of Conservation Agent who supervised plugging of this well: H. W. Hearn At Bend Ks.
Producing formation..... Depth to top..... Bottom..... Total Depth of Well 33.95 Feet
Show depth and thickness of all water, oil and gas formations.

OIL, GAS OR WATER RECORDS


CASING RECORD

Formation	Content	From	To	Size	Put In	Pulled Out
				<u>8 5/8</u>	<u>787</u>	<u>None</u>
	<u>Cement in on this pipe</u>					
	<u>set on anhydrite at 787</u>					

Describe in detail the manner in which the well was plugged, indicating where the mud fluid was placed and the method or methods used in introducing it into the hole. If cement or other plugs were used, state the character of same and depth placed, from..... feet to..... feet for each plug set.

25 bag cement displaced by sun
Cementing Co at 33.15' bringing out to
296.5'
hole filled with heavy mud to 400'
plugged solid at same 15 bag cement
displaced on same
hole filled on up to 70' plugged solid
at 70' with wood plug 10 bag cement
mixed heavy & dumped on same
cemented to bottom collar.

FILED 14 16 12W
44 15

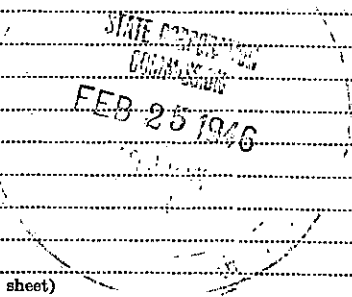

(If additional description is necessary, use BACK of this sheet)

Correspondence regarding this well should be addressed to: R. E. Day
Address: P.O. Box 429, Salina, Kansas

STATE OF Kansas, COUNTY OF Barton, SS.

Lynn Duke (employee of owner) or (owner or operator) of the above-described well,
being first duly sworn on oath, says: That I have knowledge of the facts, statements, and matters herein contained and the log of the above-
described well as filed and that the same are true and correct. So help me God.

(Signature) Lynn Duke
Box 380, Great Bend, Kansas
(Address)

SUBSCRIBED AND SWORN to before me this 22 day of February, 1946

My commission expires Oct. 7 - 1949
Elizabeth Lecture
Notary Public.

R. E. DAY ET AL - FELTES # 6
 Sec. 14, Twp. 16, R. 12W
 N $\frac{1}{2}$ - NE $\frac{1}{4}$ - NE $\frac{1}{4}$
 Barton County, Kansas

Well Log
 Figures indicate bottom of Formations

<u>Formation</u>	<u>Feet</u>	Total Depth 3395'
Soil & Clay	35	Production: Dry
Shale & Shells	225	Casing: 802' of 8 5/8" O.D.
Sand	245	
Shale & Shells	260	
Lime	295	
Shale & Shells	460	
Iron	480	
Shale & Shells	615	
Shale & Sand	685	
Shale & Shells	720	
Red Bed	778	
Anhydrite	810	
Red Bed	1000	
Shale & Shells	1240	
Salt	1450	
Shale & Shells	1490	
Lime & Shale	1855	
Lime	1930	
Lime & Shale	2290	
Shale	2600	
Lime & Shale	2700	
Shale & Lime	2780	
Lime	3030	
Lime & Shale	3105	
Lime Hard	3177	
Lime	3360	
Shale & Lime	3365	
Lime	3395	

14 16 12W
 44 15

