


STATE OF KANSAS
STATE CORPORATION COMMISSION

Give All Information Completely
Make Required Affidavit
Mail or Deliver Report to:
Conservation Division
State Corporation Commission
800 Bittling Building
Wichita, Kansas

15-009-15772-00-00
WELL PLUGGING RECORD

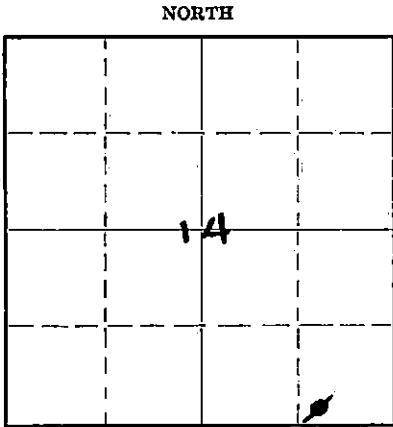

Locate well correctly on above Section Plat

Barton County. Sec. 14 Twp. 16 Rge. 12 (3) (W)
Location as "NE/CNW/SW" or footage from lines SW SE SE
Lease Owner National Cooperative Refinery Association
Lease Name Mary Weber "West" Well No. 6
Office Address 820 Union National Bank Building
Character of Well (completed as Oil, Gas or Dry Hole) Oil
Date well completed August 19, 19.45.
Application for plugging filed May 5 19.50.
Application for plugging approved May 6 19.50.
Plugging commenced May 20 19.50.
Plugging completed May 24 19.50.
Reason for abandonment of well or producing formation Oil depleted to point where producing same was unprofitable.
If a producing well is abandoned, date of last production April 1 19.50.
Was permission obtained from the Conservation Division or its agents before plugging was commenced? Yes

Name of Conservation Agent who supervised plugging of this well Stough
Producing formation Arbuckle Depth to top 3350 Bottom 3354 Total Depth of Well 3354 Feet
Show depth and thickness of all water, oil and gas formations.

OIL, GAS OR WATER RECORDS

CASING RECORD

Formation	Content	From	To	Size	Put In	Pulled Out
				8 5/8"	232'	None
				5 1/2"	3351'	2619.10"

Describe in detail the manner in which the well was plugged, indicating where the mud fluid was placed and the method or methods used in introducing it into the hole. If cement or other plugs were used, state the character of same and depth placed, from.....feet to.....feet for each plug set.
Rocked hole to 3340. Run 5 sacks cement mudded hole to 252. Set rock bridge to 235. Ran 15 sacks cement. Mudded to 40. Ran 10 sacks cement. Well complete.

67-50

RECORDED
JUN 11 1950

(If additional description is necessary, use BACK of this sheet)

Correspondence regarding this well should be addressed to National Cooperative Refinery Association
Address 820 Union National Bank Building

STATE OF Kansas COUNTY OF Sedgwick ss.
James C. Hogwood (employee of owner) or (owner or operator) of the above-described well,
being first duly sworn on oath, says: That I have knowledge of the facts, statements, and matters herein contained and the log of the above-described well as filed and that the same are true and correct. So help me God.

(Signature) James C. Hogwood
820 Union National Bank Building
(Address)

SUBSCRIBED AND SWORN to before me this 6th day of June, 19.50

I. A. Lange
Notary Public.

My commission expires February 20, 1953

23-5133-s 9-48-10M

PLUGGING
FILE SEC 14 T 16 R 12 W
BOOK PAGE 4 LINE 22

WELL LOG BUREAU—KANSAS GEOLOGICAL SOCIETY
 411 Union National Bk. Bldg., Wichita, Kans.


15-009-15772-00-00

Company - BLACK-MARSHALL OIL CO.
 Farm - Mary Weber No. 6

SEC. 14 T. 16 R. 12 W
 SWc SE

Total Depth. 3378'
 Comm. 8-8-45 Comp. 8-19-45
 Shot or Treated.
 Contractor. Ferrell-Young Drlg. Co.
 Issued. 11-3-45

County. Barton
 KANSAS

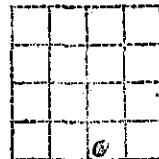

CASING:

8 5/8" 232' Cem.
 5" 3351' Cem.

Elevation. _____

Production. Pot. 503 BO plus
 8% wtr.

Figures Indicate Bottom of Formations.

cellar	4
shale & sand	232
shale	245
sand	260
shale & shells	320
anhydrite	825
shale & shells	1250
shale & salt	1365
shale & shells	1480
shale & lime	2230
shale	2490
shale & lime	2805
lime	2860
lime & shale	2940
lime	3000
shale & lime	3085
lime brkn	3130
lime & shale	3378
Total Depth.	

Tops;	
Anhydrite	798
Lansing Wh.	3099
Base K. C.	3337
Conglomerate	3345
Gorham sand	3350

PLUGGING
 FILE SEC 14 T 16 R 12W
 BOOK PAGE 4 DATE 22

RECEIVED
 JUL 29 1950
 STATE COMMISSION
 KANSAS

LIBRARY
NOV 8 - 1945
JUL 1945