

STATE OF KANSAS
STATE CORPORATION COMMISSION

WELL PLUGGING RECORD


OR

FORMATION PLUGGING RECORD

Strike out upper line
when reporting plug-
ging off formations.

Give All Information Completely
Make Required Affidavit
Mail or Deliver Report to:
Conservation Division
State Corporation Commission
800 Biting Building
Wichita, Kansas

NORTH

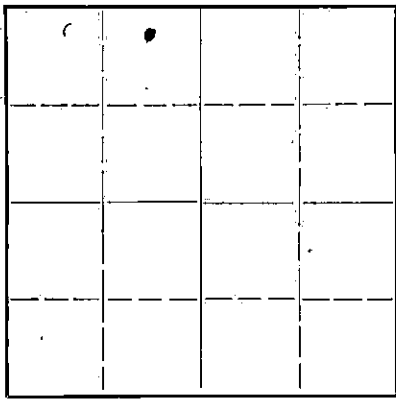

Locate well correctly on above
Section Plat

Barton County, Sec. 14 Twp. 16 Rge. (E) 12 West

Location as "NE $\frac{1}{4}$ NW $\frac{1}{4}$ SW $\frac{1}{4}$ " or footage from lines N $\frac{1}{2}$ NE $\frac{1}{2}$ NW $\frac{1}{2}$

Lease Owner R. E. Day

Lease Name Theisen & Hoffman Well No.

Office Address Box 429, Salina, Kansas

Character of Well (completed as Oil, Gas or Dry Hole) Dry Hole

Date well completed July 8 1942

Application for plugging filed July 8 1942

Application for plugging approved July 9 1942

Plugging commenced July 9 1942

Plugging completed July 15 1942

Reason for abandonment of well or producing formation Hole full of water

If a producing well is abandoned, date of last production 19

Was permission obtained from the Conservation Division or its agents before plugging was com-
menced? Yes

Name of Conservation Agent who supervised plugging of this well C. T. Alexander

Producing formation Depth to top Bottom Total Depth of Well 3385 Feet

Show depth and thickness of all water, oil and gas formations.

OIL, GAS OR WATER RECORDS

CASING RECORD

| Formation | Content | From | To | Size | Put In | Pulled Out |
|-------------|--------------|------|------|------|--------|------------|
| Sand | 8 - B.W. | 245 | 255' | 13" | 353 | 353 |
| Shale | 8 - B.W. | 280 | 310 | 8" | 2200 | 2200 |
| Sand | H.F.W. | 310 | 330 | 7" | 2910 | 2910 |
| Red Rock | 1/2- B.W. | 1750 | 1760 | 5" | 3352 | 3352 |
| Lime | 1 1/2 - B.W. | 3202 | 3210 | | | |
| Lime- Show | Oil & Gas | 3210 | 3219 | | | |
| Lime- Show | Oil | 3352 | 3355 | | | |
| Lime- Show | Oil | 3357 | 3362 | | | |
| Lime & Sand | H.F.W. | 3376 | 3385 | | | |

Describe in detail the manner in which the well was plugged, indicating where the mud fluid was placed and the method or methods used in introducing it into the hold. If cement or other plugs were used, state the character of same and depth placed, from feet to feet for each plug set.

Cement from 3385' to 3342'


Mud from 3342' to 275'

Permanent Bridge at 275' to 255'

Mud from 255' to 18'

Cement from 18' to 8'

Mud from 8' to Top

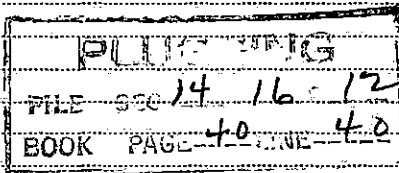

pd
9/31/42
Ho

(If additional description is necessary, use BACK of this sheet)

Correspondence regarding this well should be addressed to R. E. Day
Address Box 429, Salina, Kansas

STATE OF Kansas COUNTY OF Saline ss.
R. E. Day (employee of owner) or (owner or operator) of the above-described well,

being first duly sworn on oath, says: That I have knowledge of the facts, statements, and matters herein contained and the log of the above-described well as filed and that the same are true and correct. So help me God.

(Signature) R. E. Day 3-6-43
Box 429, Salina, Kansas

SUBSCRIBED AND SWORN to before me this 5th day of May 1943

Edith W. Brown
Notary Public

My commission expires May 18, 1946



15-009-15779-00-00

R. E. DAY - THEISEN & HOFFMAN # 1
 NE $\frac{1}{4}$ of NW $\frac{1}{4}$ Sec.14 Twp.16 Range 12West
 Barton County, Kansas

WELL RECORD

| <u>Formation</u> | <u>Feet</u> | <u>Formation</u> | <u>Feet</u> | <u>Water Record</u> |
|------------------|-------------|------------------|-------------|-------------------------------|
| Clay | 20 | Shale | 2435 | 8-B.W. 245' to 255' |
| Shale Blue | 35 | Lime | 2440 | 8-B.W. 280' to 310' |
| Shale Dark | 100 | Shale & Shells | 2470 | H.F.W. 310 to 330' |
| Blue Muck | 145 | Shale Gray | 2485 | 1/2-B.W. 1750' to 1760' |
| Shale Gray | 170 | Lime | 2500 | 1-1/2-B.W. 3202' to 3210' |
| Shale Blue | 190 | Shale Blue | 2515 | Show Oil & Gas 3210' to 3219' |
| Red Rock | 220 | Lime | 2525 | Show Oil 3352' to 3355' |
| Sand | 250 | Shale | 2530 | Show Oil 3357' to 3362' |
| Shale | 280 | Lime | 2545 | H.F.W. 3376' to 3383' |
| Red Rock | 300 | Shale Blue | 2550 | H.F.W. 3383' to 3385' |
| Shale Gray | 310 | Lime | 2555 | |
| Sand | 330 | Shale Blue | 2560 | |
| Red Rock | 340 | Lime | 2565 | <u>Casing</u> |
| Shale Blue | 365 | Shale Blue | 2570 | 13" 353' |
| Sand Water | 375 | Lime | 2580 | 8" 2200' |
| Broken Sand | 400 | Shale & Shells | 2625 | 7" 2910' |
| Sand | 455 | Shale Blue | 2665 | 5" 3352' |
| Shale Blue | 460 | Lime | 2835 | |
| Lime Gray | 465 | Shale | 2845 | |
| Shale Blue | 475 | Lime | 2870 | |
| Shale Light | 485 | Shale | 2875 | |
| Shale Blue | 510 | Lime | 2980 | |
| Shale Gray | 535 | Shale | 2990 | |
| Red Rock | 793 | Lime Dodge | 3008 | |
| Lime | 815 | Red Rock | 3013 | |
| Red Rock | 1010 | Lime | 3015 | |
| Shale Blue | 1080 | Shale & Shells | 3070 | |
| Red Rock | 1125 | Lime | 3200 | |
| Shale Blue | 1225 | Shale Black | 3202 | |
| Salt | 1465 | Lime | 3275 | |
| Shale Blue | 1470 | Shale | 3285 | |
| Shale & Shells | 1545 | Lime | 3329 | |
| Lime | 1560 | Shale | 3332 | |
| Lime Broken | 1655 | Lime | 3347 | |
| Shale Blue | 1660 | Shale Green | 3352 | |
| Lime Broken | 1680 | Lime Sandy | 3355 | |
| Lime | 1715 | Lime | 3376 | |
| Red Rock | 1735 | Lime Sandy | 3380 | |
| Lime | 1895 | Sand Gray | 3383 | |
| Shale Light | 1905 | Sand | 3385 | |
| Lime | 1940 | | | |
| Shale Blue | 1950 | | | |
| Lime | 1965 | | | |
| Red Rock | 1970 | | | |
| Lime | 1990 | | | |
| Shale Blue | 1995 | | | |
| Lime | 2010 | | | |
| Red Rock | 2020 | | | |
| Lime | 2025 | | | |
| Shale Blue | 2030 | | | |
| Lime | 2080 | | | |
| Red Rock | 2085 | | | |
| Lime | 2140 | | | |
| Shale Blue | 2160 | | | |
| Red Rock | 2165 | | | |
| Lime | 2180 | | | |
| Shale | 2195 | | | |
| Shale Blue | 2200 | | | |
| Lime | 2205 | | | |
| Shale Blue | 2210 | | | |
| Lime Broken | 2230 | | | |
| Lime | 2235 | | | |
| Shale Blue | 2240 | | | |
| Lime | 2250 | | | |
| Shale Blue | 2315 | | | |
| Shale & Shells | 2360 | | | |
| Lime | 2370 | | | |
| Shale & Shells | 2395 | | | |
| Lime | 2405 | | | |
| Shale | 2420 | | | |
| Lime | 2425 | | | |

14 16 12 W
 40 40