

STATE OF KANSAS  
STATE CORPORATION COMMISSION


WELL PLUGGING RECORD

Give All Information Completely  
Make Required Reports  
Mail or Deliver Report to:  
Conservation Division  
State Corporation Commission  
800 Bitting Building  
Wichita, Kansas

OR  
FORMATION PLUGGING RECORD

Strike out upper line  
when reporting plug-  
ging off formations.

Rice County Sec. 21 Twp. 21 Rge. (E) 9 (W)

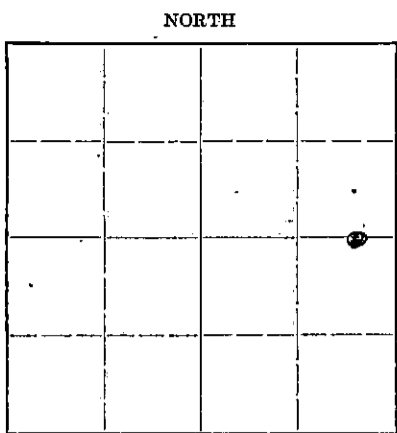

Locate well correctly on above  
Section Plat

Location as "NE $\frac{1}{4}$ NW $\frac{1}{4}$ SW $\frac{1}{4}$ " or footage from lines.....  
Lease Owner... E. C. Mingenbeck  
Lease Name... Hand Well No. 1  
Office Address... McPherson, Kansas  
Character of Well, (completed as Oil, Gas or Dry Hole)... Gas  
Date well completed..... 19.....  
Application for plugging filed... 11-9-47 19.47  
Application for plugging approved... 11-9 19.47  
Plugging commenced... 11-9 19.47  
Plugging completed... 11-16 19.47  
Reason for abandonment of well or producing formation... Stopped Producing.

If a producing well is abandoned, date of last production..... 19.....  
Was permission obtained from the Conservation Division or its agents before plugging was com-  
menced?..... Yes

Name of Conservation Agent who supervised plugging of this well... Ruel Durkee  
Producing formation..... Depth to top..... Bottom..... Total Depth of Well... 3318 Feet

Show depth and thickness of all water, oil and gas formations.

OIL, GAS OR WATER RECORDS

CASING RECORD

Formation	Content	From	To	Size	Put In	Pulled Out
				7-inch		2418.35'

Describe in detail the manner in which the well was plugged, indicating where the mud fluid was placed and the method or methods used in introducing it into the hold. If cement or other plugs were used, state the character of same and depth placed, from..... feet to..... feet for each plug set.

Pumped full of heavy mud. Dumped 10 Sacks cement at 250'. Filled with mud to top with 5 sacks at top.

DEC 27 1947

(If additional description is necessary, use BACK of this sheet)

Correspondence regarding this well should be addressed to... Sterling Drilling Company  
Address... Sterling, Kansas

STATE OF Kansas COUNTY OF Rice, ss.  
Rollin Mead (employee of owner) or (owner or operator) of the above-described well,

being first duly sworn on oath, says: That I have knowledge of the facts, statements, and matters herein contained and the log of the above-described well as filed and that the same are true and correct. So help me God.

(Signature) Rollin Mead  
Sterling, Kansas (Address)

SUBSCRIBED AND SWORN TO before me this 8th day of December, 1947

My commission expires August 17, 1949

[Signature] Notary Public.

21-6856-RS 3-47-6M

PLUGGING  
FILE SEC 21 T 21 R 9W  
BOOK PAGE 146 LINE 7

B & R DRILLING COMPANY  
John Hand #1 Sec. 21 Twp. 15 Rge. 9W  
County: Rice, Kansas

Total Depth: 3322'  
Comm: 11/20/41 Comp: 12/20/41  
Contractor: B & R Drilling Co.  
Issued: 4/3/42

Casing.  
10" surface 105'  
7" oil string 3313'

Formation	Depth
Sand & gravel	50'
Red bed	108'
Red bed	195'
Shale & shells	585'
Shale & lime shells	800'
Shale & shells	840'
Salt & shale	1100'
Shale & shells	1135'
Lime & shale	1220'
Shale & shells	1310'
Lime & shale	1350'
Lime	1495'
Sand	1520'
Lime & shale	1555'
Lime	1675'
Shale & shells	1765'
Lime	1855'
Shale & shells	1925'
Lime & shale	1995'
Shale	2050'
Lime	2070'
Shale & shells	2185'
Shale	2205'
Lime & shale	2250'
Broken lime	2315'
Broken lime & shale	2380'
Shale	2395'
Lime	2410'
Shale & shells	2470'
Shale	2500'
Lime	2535'
Lime	2800'
Shale & lime	2875'
Shale & lime	2950'
Shale & shells	2985'
Lime	3095'
Chert	3110'
Lime	3260'
Conglomerate	3310'
Shale, red	3311'
Shale, green sandy	3313'
Sand	3315'
Sandy lime	3322'

STATE OF KANSAS )  
                          ) SS  
RUSSELL COUNTY )

I HEREBY CERTIFY THAT THE ABOVE INFORMATION IS TRUE AND CORRECT TO THE BEST OF MY KNOWLEDGE.

*[Signature]*

SUBSCRIBED AND SWORN TO BEFORE ME THIS 30TH DAY OF DECEMBER, 1947.

*[Signature]*

MY COMM. EXPIRES 6/17/50

NOTARY PUBLIC

PLUGGING  
FILE SEC 21 T21 R 9W  
146