


STATE OF KANSAS
STATE CORPORATION COMMISSION

Form CP-4

Give All Information Completely
Make Required Affidavit
Mail or Deliver Report to:
Conservation Division
State Corporation Commission
P. O. Box 17027
Wichita, Kansas 67217
NORTH

WELL PLUGGING RECORD

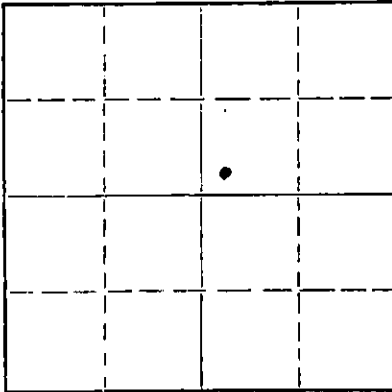

Locate well correctly on above
Section Plat

Rice County. Sec. 9 Twp. 21 Rge. (E) 10 (W)
Location as "NE/CNW/SW" or footage from lines SW SW NE
Lease Owner Lebsack Oil Production, Inc.
Lease Name Snider "A" Well No. 1
Office Address Box 489, Hays, Kansas 67601
Character of Well (completed as Oil, Gas or Dry Hole) oil
Date well completed 19____
Application for plugging filed Sept. 5 1972
Application for plugging approved 19____
Plugging commenced Sept. 8 1972
Plugging completed Sept. 12 1972
Reason for abandonment of well or producing formation depleted

If a producing well is abandoned, date of last production 19____
Was permission obtained from the Conservation Division or its agents before plugging was commenced? YES

Name of Conservation Agent who supervised plugging of this well Gilbert Toman
Producing formation _____ Depth to top _____ Bottom _____ Total Depth of Well 3395 Feet
Show depth and thickness of all water, oil and gas formations.

OIL, GAS OR WATER RECORDS

CASING RECORD

FORMATION	CONTENT	FROM	TO	SIZE	PUT IN	PULLED OUT
		0	200'	8 5/8"	200'	none
		0	2650'	4 1/2"	2650'	1423.30

Describe in detail the manner in which the well was plugged, indicating where the mud fluid was placed and the method or methods used in introducing it into the hole. If cement or other plugs were used, state the character of same and depth placed, from _____ feet to _____ feet for each plug set.

Sanded back to 2500' and dumped 4 sacks of cement.

Set 10' rock bridge at 200' and plugged well with 35 sacks of cement.

RECEIVED
STATE CORPORATION COMMISSION
SEP 20 1972
CONSERVATION DIVISION
Wichita, Kansas

(If additional description is necessary, use BACK of this sheet)
Name of Plugging Contractor PIPE PULLERS, INC.
Address Box 486, Ellinwood, Kansas 67526

STATE OF KANSAS, COUNTY OF BARTON, ss.
Evelyn Roth

(employee of owner) or (owner or operator) of the above-described well, being first duly sworn on oath, says: That I have knowledge of the facts, statements, and matters herein contained and the log of the above-described well as filed and that the same are true and correct. So help me God.

(Signature) Evelyn Roth
Ellinwood, Kansas

(Address)

SUBSCRIBED AND SWORN to before me this 19th day of September 1972

My commission expires

Feb. 10, 1975

Notary Public.

WELL LOG BUREAU—KANSAS GEOLOGICAL SOCIETY
508 East Murdock, Wichita, Kansas


COPY

Company- SCHERMERHORN OIL CORPORATION
Farm- Snider "A" No. 1

SEC. 9 T. 21 R. 10W
SW SW NE

Total Depth. 3395
Comm. 3-7-53 Comp. 3-16-53
Shot or Treated.
Contractor. Badger Drillers, Inc.
Issued. 4-11-53

County Rice KANSAS

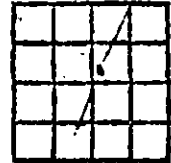

CASING:
8 5/8" 200' cem w/300 sx

Elevation. 1723

Production. dry

Figures Indicate Bottom of Formations.

surface clay	30
sand	95
red bed	370
anhydrite	403
shale, shells	1200
shale, lime	1650
lime	1800
lime, shale	2500
lime	2885
shale, lime	2991
lime	3395
Total Depth	

Tops: Scout	
Heebner	2819
Toronto	2866
Douglas	2878
Brown Lime	2981
Lansing	3007
Conglomerate	3302
Simpson	3333
Arbuckle	3385

RECEIVED
STATE CORPORATION COMMISSION

SEP 6 1972

CONSERVATION DIVISION
Wichita, Kansas