


WELL PLUGGING RECORD

Give All Information Completely
Make Required Affidavit
Mail or Deliver Report to:
Conservation Division
State Corporation Commission
311 No. Broadway
Wichita, Kansas

Rice County. Sec. 9 Twp. 21 Rge. 10 (E) (W) X

NORTH

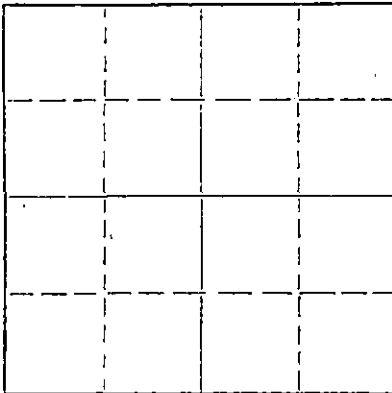

Locate well correctly on above
Section Plat

Location as "NE/CNW/SW" or footage from lines SE SE SW
Lease Owner Apco Oil Corporation
Lease Name Ernest Boy Well No. 1
Office Address P. O. Box 1841 Oklahoma City, Oklahoma 73101
Character of Well (completed as Oil, Gas or Dry Hole)
Date well completed 19
Application for plugging filed 9-24-70 19
Application for plugging approved 9-25-70 19
Plugging commenced 9-29-70 19
Plugging completed 10-3-70 19
Reason for abandonment of well or producing formation

If a producing well is abandoned, date of last production 19
Was permission obtained from the Conservation Division or its agents before plugging was commenced? Yes

Name of Conservation Agent who supervised plugging of this well Gilbert Toman
Producing formation Depth to top Bottom Total Depth of Well 3508 Feet
Show depth and thickness of all water, oil and gas formations.

OIL, GAS OR WATER RECORDS

CASING RECORD

FORMATION	CONTENT	FROM	TO	SIZE	PUT IN	PULLED OUT
				8 5/8	202	None
				5 1/2	3501	1525', 11

RECEIVED
STATE CORPORATION COMMISSION
OCT 12 1970
CONSERVATION DIVISION
Wichita, Kansas

Describe in detail the manner in which the well was plugged, indicating where the mud fluid was placed and the method or methods used in introducing it into the hole. If cement or other plugs were used, state the character of same and depth placed, from feet to feet for each plug set.

Moved unit into location and rigged up. Pushed plug to 3390' and dumped 30 gallons of sand. Dug cellar. Mixed and dumped 5 sacks of cement on bottom. Installed stripper head. Had 7 1/2" tension at 2500 psi and 10 1/2" at 3000 psi. Shot casing at 2804' and working casing. Gained 20" tension at 3000 psi and 17" at 2500 psi. Shot casing at 2310', 2005', 1802' and 1524'. Pipe was free. Laid down a total of 49 joints of 5 1/2" casing. Mudded hole to 200' and dumped a 10' rock bridge. Dumped 25 sacks of cement. Mudded hole to 40' and dumped a 10' rock bridge. Capped the well with 10 sacks of cement.

(If additional description is necessary, use BACK of this sheet)

Name of Plugging Contractor Forbes Casing Pulling Company, Inc.
Address P. O. Box 221 Great Bend, Kansas 67530

STATE OF Kansas COUNTY OF Barton ss.
James W. Rockhold (employee of owner) or (owner or operator) of the above-described well, being first duly sworn on oath, says: That I have knowledge of the facts, statements, and matters herein contained and the log of the above-described well as filed and that the same are true and correct. So help me God.

(Signature) James W. Rockhold
P. O. Box 221 Great Bend, Kansas
(Address)

SUBSCRIBED AND SWORN to before me this 7 day of October, 19 70



My commission expires May 27, 1973 Notary Public.

RECEIVED
STATE CORPORATION COMMISSION
SEP 25 1970
CONSERVATION DIVISION
Wichita, Kansas

ERNEST BOY #1


SE SE SW Section 9-21S-10W
Rice County, Kansas
SCHEPHERHORN OIL CORPORATION

8 5/8" O. D. Casing cemented at 200'
5 1/2" O. D. Casing cemented at 3692'

Drilling started 1-25-53
Drilling completed 2-8-53

<u>FROM</u>	<u>TO</u>	<u>FORMATION</u>	<u>REMARKS</u>
0'	115'	Sand and gravel	
115'	170'	Sand and shale	
170'	200'	Red bed	8 5/8" O. D. Casing
200'	355'	Red bed	Cemented at 200'
355'	380'	Anhydrite	
380'	1400'	Shale and shells	
1400'	3049'	Lime and shale	
3049'	3315'	Lime	
3315'	3330'	Red shale and lime	
3330'	3376'	Lime and chert	
3376'	3408'	Lime and shale	
3408'	3412'	Lime	
3412'	3421'	Lime and chert	
3421'	3660'	Lime	
3660'	3673'	Lime and chert	
3673'	3692'	Lime	5 1/2" O. D. Casing Cemented at 3692'

This is a true copy of the Driller's Log as shown on the Drilling Reports.

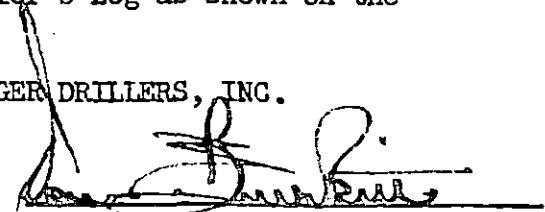BADGER DRILLERS, INC.
By: 

Subscribed and sworn to before me this 6th day of March 1953.

My commission expires: Jan. 7, 1956 Eva M. Davis
Notary Public