


STATE OF KANSAS
STATE CORPORATION COMMISSION

Give All Information Completely
Make Required Affidavit
Mail or Deliver Report to:
Conservation Division
State Corporation Commission
800 Bitting Building
Wichita, Kansas

WELL PLUGGING RECORD

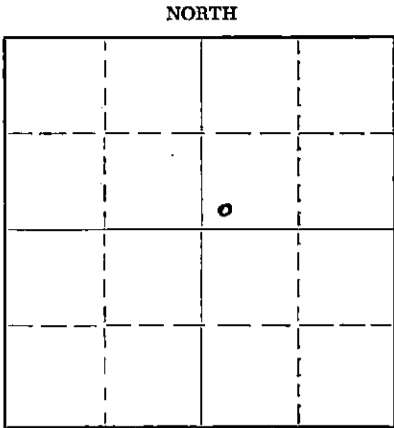

Locate well correctly on above
Section Flat

Rice County. Sec. 9 Twp. 21 Rge. 10 (E) (W)
Location as "NE/CNW/SW" or footage from lines SW SW on E 330 ft. South
Lease Owner Schermerhorn Oil Corp. 330 " West line
Lease Name Snider Well No. 1
Office Address 714 First Nat'l. Bldg., Tulsa, Oklahoma
Character of Well (completed as Oil, Gas or Dry Hole) Dry
Date well completed 3-14 19 53
Application for plugging filed 3-14 19 53
Application for plugging approved 3-14 19 53
Plugging commenced 3-14 19 53
Plugging completed 3-20 19 53
Reason for abandonment of well or producing formation Dry

If a producing well is abandoned, date of last production _____ 19____
Was permission obtained from the Conservation Division or its agents before plugging was commenced? Yes

Name of Conservation Agent who supervised plugging of this well Derkee
Producing formation _____ Depth to top _____ Bottom _____ Total Depth of Well 3395 Feet
Show depth and thickness of all water, oil and gas formations.

OIL, GAS OR WATER RECORDS

CASING RECORD

FORMATION	CONTENT	FROM	TO	SIZE	PUT IN	PULLED OUT
		0	200	8-5/8"	Cemented	

Describe in detail the manner in which the well was plugged, indicating where the mud fluid was placed and the method or methods used in introducing it into the hole. If cement or other plugs were used, state the character of same and depth placed, from _____ feet to _____ feet for each plug set.

3395 to 200
200 to 190 bridge
190 to bottom cellar cement

Read 4-16-53

(If additional description is necessary, use BACK of this sheet)

Name of Plugging Contractor Badger Drillers, Inc.
Address Tulsa, Oklahoma


STATE OF OKLAHOMA, COUNTY OF TULSA, ss. _____ (employee of owner) or (owner or operator) of the above-described well, being first duly sworn on oath, says: That I have knowledge of the facts, statements, and matters herein contained and the log of the above-described well as filed and that the same are true and correct. So help me God.

(Signature) (Signed) Ole Williams

This is a true certified copy. Albert, Kansas (Address)

SUBSCRIBED AND SWORN TO before me this 15th day of April, 19 53

My commission expires January 7, 1956. Eva M. Davis Notary Public.

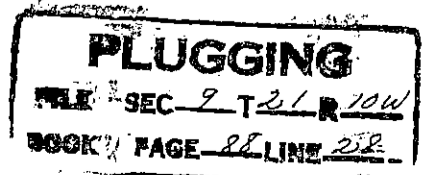

WELDER "A" #1

SW-33-NE Sec. 9-218-10W
 Rice CO., Kansas
 Schenmerhorn Oil Corporation

8 5/8" O.D. Casing cemented at 200'

Drilling started 3-7-53
 Drilling completed 3-16-53

<u>FROM</u>	<u>TO</u>	<u>FORMATION</u>	<u>REMARKS</u>
0	30	Surface clay	
30	95	Sand	
95	370	Red bed	8 5/8" Csg. set at 200'
370	403	Anhydrite	w/300 sacks cement
403	1200	Shale & shells	
1200	1650	Shale & lime	
1650	1800	Lime	
1800	2500	Lime & shale	
2500	2885	Lime	
2885	2991	Shale & lime	
2991	3395 P.D.	Lime	D. & A.

This is a certified true copy of the Driller's log
 as shown on the Drilling Reports.

WELDER DRILLERS, INC.

By: *[Signature]*

Subscribed and sworn to before me this 31st
 day of March 1953.

My commission expires: 4-13-54

[Signature]
 Notary Public

PLUGGING


RECEIVED
 STATE CORPORATION