

STATE OF KANSAS
STATE CORPORATION COMMISSION


15-145-20529-0000

WELL PLUGGING RECORD

Give All Information Completely
Make Required Affidavit
Mail or Deliver Report to
Conservation Division
State Corporation Comm.
245 North Water
Wichita, KS 67202

Pawnee County, Sec. 19 Twp. 23S Rge. 15WE/W
Location as "NE/CNW $\frac{1}{4}$ /SW $\frac{1}{4}$ " or footage from lines
E/2 NW SE

Lease Owner Alpine Drilling Co., Inc.
Lease Name Wurm Well No. A-2
Office Address 800 Bitting Building, Wichita, KS
Character of Well (Completed as Oil, Gas or Dry Hole)
Dry Hole

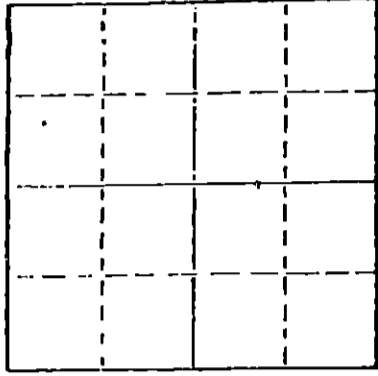

Date Well completed August 3 19 78
Application for plugging filed August 3 19 78
Application for plugging approved August 3 19 78
Plugging commenced August 3 19 78
Plugging completed August 3 19 78
Reason for abandonment of well or producing formation

If a producing well is abandoned, date of last production 19

Was permission obtained from the Conservation Division or its agents before plugging was commenced? yes

Name of Conservation Agent who supervised plugging of this well Leo Massey
Producing formation Depth to top Bottom Total Depth of Well 4118
Show depth and thickness of all water, oil and gas formations.

OIL, GAS OR WATER RECORDS

CASING RECORD

FORMATION	CONTENT	FROM	TO	SIZE	PUT IN	PULLED OUT

Describe in detail the manner in which the well was plugged, indicating where the mud fluid was placed and the method or methods used in introducing it into the hold. If cement or other plugs were used, state the character of same and depth placed, from feet to feet for each plug set.

Plugged with 50 sx @ 420
25 sx @ 240
plug + 10 sx @ 40
Plugged @ 9:45 p.m. August 3, 1978

RECEIVED
STATE CORPORATION COMMISSION

AUG 11 1978

(If additional description is necessary, use BACK OF CONDITIONAL DIVISION SHEET)
Name of Plugging Contractor

STATE OF KANSAS COUNTY OF SEDGWICK, ss.
Jon T. Williams, Jr. (employee of owner) or (owner or operator)

of the above-described well, being first duly sworn on oath, says: That I have knowledge of the facts, statements, and matters herein contained and the log of the above-described well as filed and that the same are true and correct. So help me God.

(Signature) [Signature]
800 Bitting Bldg., Wichita, KS
(Address)

SUBSCRIBED AND SWORN TO before me this 3rd day of August, 1978

[Signature]
Geraldine Stewart Notary Public.

My commission expires January 12, 1981





800 Bitting Bldg
Wichita, Kansas 67202
Phone 316 - 263-7904
Mobile Phone 316 - 793-7859 Unit 7070

15-145-20529-0000

Invoice No.

August 8, 1978

WELL LOG ----- -WURM A-2

Located: E/2 NW SE of Sec. 19-23S-15W E/W,
Pawnee County, Kansas.

OWNER: Alpine Drilling Co., Inc.
ROTARY CONTRACTOR: Husky Drilling Co., Inc.

COMMENCED: 7/17/78
COMPLETED: 8/03/78

TOTAL DEPTH: 4118'

LOG

CASING RECORD

0 - 80	Sand and clay
80 - 340	Shale and Sand
340 - 373	Red Bed
373 - 985	Shale, Sand and Red Bed
985 - 1002	Anhydrite
1002 - 1355	Shale
1335 - 1830	Shale, Shells, Salt
1830 - 3065	Shale and Lime
3065 - 3085	Lime
3085 - 3643	Lime and Shale
3643 - 3734	Lime
3734 - 3970	Lime and Shale
3970 - 4060	Lime, Shale, Chert
4060 - 4118	Lime, Shale, Sand and Chert

Ran 8 joints 8 5/8", 28#, 8V,
rge. 3, used casing - tallied
343.22, set at 358 KB w/260
sacks common 2% gel, 3% cc -
circulated-plugged down at
11:30 P.M. by Allied.

RECEIVED
STATE CORPORATION COMMISSION

AUG 11 1978

CONSERVATION DIVISION
Wichita, Kansas

Plugged 8 - 03 - 78