

15-143-00489-0000


STATE OF KANSAS
STATE CORPORATION COMMISSION

Give All Information Completely
Make Required Affidavit
Mail or Deliver Report to:
Conservation Division
State Corporation Commission
212 North Market, Insurance Bldg.
Wichita, Kansas

WELL PLUGGING RECORD

Rawlins County, Sec. 19 Twp. 13 Rge. (E) 15 (W)

Location as "NE/CNW/SW" or footage from lines SW SW NW
Lease Owner Aylward Drilling Company
Lease Name Wiles "A" Well No. 1
Office Address 813 1st National Bank Bldg. - Wichita 2, Kansas
Character of Well (completed as Oil, Gas or Dry Hole) Dry Hole
Date well completed November 17 19 60
Application for plugging filed November 17 19 60
Application for plugging approved November 17 19 60
Plugging commenced November 17 19 60
Plugging completed November 17 19 60
Reason for abandonment of well or producing formation _____

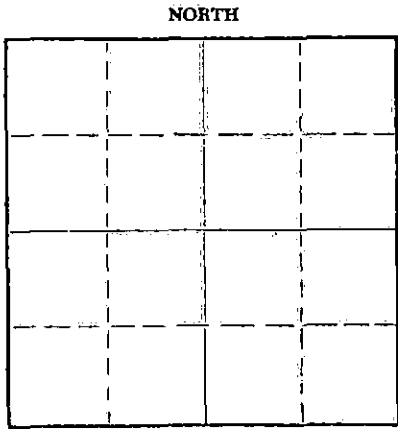

Locate well correctly on above
Section Plat

If a producing well is abandoned, date of last production _____ 19 ____
Was permission obtained from the Conservation Division or its agents before plugging was commenced? Yes

Name of Conservation Agent who supervised plugging of this well Frank Broadfoot
Producing formation _____ Depth to top _____ Bottom _____ Total Depth of Well 4254 Feet
Show depth and thickness of all water, oil and gas formations.

OIL, GAS OR WATER RECORDS

CASING RECORD

FORMATION	CONTENT	FROM	TO	SIZE	PUT IN	PULLED OUT
				<u>8 5/8"</u>	<u>395</u>	<u>None</u>

Describe in detail the manner in which the well was plugged, indicating where the mud fluid was placed and the method or methods used in introducing it into the hole. If cement or other plugs were used, state the character of same and depth placed, from _____ feet to _____ feet for each plug set.

Heavy mud 4254 to 300'
Plug at 300 with 20 sacks cement
and 1/3 sack hulls
Heavy mud to 30'
Plug at 30' with 1/3 sack hulls
and cement to bottom of cellar

(If additional description is necessary, use BACK of this sheet)

Name of Plugging Contractor Company tools
Address _____

STATE OF KANSAS, COUNTY OF SEDGWICK, ss.
Charles D. Williams (employee of owner ~~XXXXXXXXXX~~) of the above-described well, being first duly sworn on oath, says: That I have knowledge of the facts, statements, and matters herein contained and the log of the above-described well as filed and that the same are true and correct. So help me God.

(Signature) Charles D. Williams
813 1st Nat'l Bank Bldg. - Wichita 2, Kansas
(Address)

SUBSCRIBED AND SWORN TO before me this 23rd day of November, 19 60

My commission expires December 11, 1961
Duane Jessup Notary Public.

WILES "A" #1

15-195-00489-0000

Casing Record: 8 5/8" - 395'
 Company: Aylward Drilling Company
 Contractor: Aylward Drilling Company
 Location: SW SW NW 19-23-15W
 Pawnee County
 Kansas
 Commenced: November 6, 1960
 Completed: November 17, 1960
 Elevation: 2040 R.B.

	From	To	Remarks
Shale	0	65	Set 8 5/8" surface pipe at 395' w/275 sacks cement.
Sand	65	83	
Shale & Shells	83	350	Geological Tops:
Sand & Shale	350	385	
Shale & Shells	385	475	Heebner 3549
Sand	475	535	Toronto 3572
Shale, Shells & Red Bed	535	995	Douglas 3592
Anhydrite	995	1025	Brown Lime 3677
Shale & Shells	1025	1544	Lansing 3687
Shale & Sand	1544	1575	Base Kansas City 3942
Shale	1575	1855	Viola 4076
Shale & Lime	1855	2085	Simpson 4143
Broken Lime	2085	2190	Arbuckle 4195
Shale, Lime & Sand	2190	2395	DST 3693-3851 Open 1 hr. Str. bl. Rec. 1480' SW
Lime & Shale	2395	2510	
Shale & Lime	2510	2695	IBHP 1250#/20" - FBHP 1160#/20"
Lime & Shale	2695	2890	FP 210#-670#
Shale & Lime	2890	3195	DST 4086-4138 Open 1 hr. Rec. 110' mud w/few specks oil
Lime & Shale	3195	3328	
Shale & Lime	3328	3435	IBHP 435#/20" - FBHP 210#/30"
Lime	3435	3580	FP 0-0#
Shale & Lime	3580	3724	No log run
Lime	3724	4135	
Lime & Shale	4135	4147	D & A
Lime, Chert & Shale	4147	4175	
Lime & Shale	4175	4195	RECEIVED STATE CORPORATION COMMISSION JUN 27 1962 CONSERVATION DIVISION Wichita, Kansas
Dolomite	4195	4254 T.D.	

I hereby certify that this is a true and correct copy of the above log to the best of my knowledge.

Charles B. Williams

Subscribed and sworn to before me this 22nd day of November, 1960

Duane Jessup
 DUANE JESSUP Notary Public

My commission expires December 11, 1961