

WELL PLUGGING RECORD

Give All Information Completely  
Make Required Affidavit  
Mail or Deliver Report to:  
Conservation Division  
State Corporation Commission  
211 No. Broadway  
Wichita, Kansas

Pawnee County. Sec. 19 Twp. 23 Rge. 15 ~~XX~~ (W)

Location as "NE/CNW%SW%" or footage from lines SE SW NE

Lease Owner Stanolind Oil and Gas Company

Lease Name O. P. McComas "B" Well No. 1

Office Address Box 1654, Oklahoma City, Oklahoma

Character of Well (completed as Oil, Gas or Dry Hole) Gas

Date well completed 11-21- 19 53

Application for plugging filed 10-31- 19 56

Application for plugging approved 11-1- 19 56


Plugging commenced 11-13- 19 56

Plugging completed 11-21- 19 56

Reason for abandonment of well or producing formation Economically Depleted

If a producing well is abandoned, date of last production 9-18- 19 56

Was permission obtained from the Conservation Division or its agents before plugging was commenced? Yes

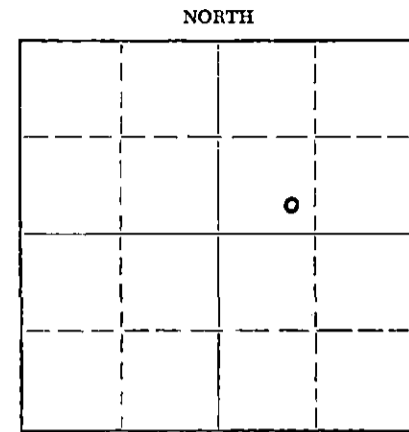

Locate well correctly on above Section Plat

Name of Conservation Agent who supervised plugging of this well R. M. Brundage

Producing formation Arbuckle Depth to top 4086 Bottom 4150 Total Depth of Well 4150 Feet

Show depth and thickness of all water, oil and gas formations.

OIL, GAS OR WATER RECORDS

CASING RECORD

FORMATION	CONTENT	FROM	TO	SIZE	PUT IN	PULLED OUT
<u>Arbuckle</u>	<u>Water - Gas</u>	<u>4086</u>	<u>4150</u>	<u>8-5/8</u>	<u>374</u>	<u>None</u>
				<u>5-1/2</u>	<u>4178</u>	<u>2219</u>

Describe in detail the manner in which the well was plugged, indicating where the mud fluid was placed and the method or methods used in introducing it into the hole. If cement or other plugs were used, state the character of same and depth placed, from \_\_\_\_\_ feet to \_\_\_\_\_ feet for each plug set.

Dumped Sand 4150-4075  
5 Sx Cement 4075-4029  
Hvy Mud 4029- 300  
Crushed Rock 300- 290  
20 Sx Cement 290- 230  
Hvy Mud 230- 40  
Crushed Rock 40- 30  
10 Sx Cement 30 To Base of Cellar

RECEIVED  
STATE CORPORATION COMMISSION

11-28-56

CONSERVATION DIVISION  
Wichita, Kansas

(If additional description is necessary, use BACK of this sheet)

Name of Plugging Contractor West Supply Company, Inc.

Address Chase, Kansas

STATE OF KANSAS COUNTY OF BARTON ss.

I, G. A. Reynolds (employee of owner) or ~~owner~~ of the above-described well, being first duly sworn on oath, says: That I have knowledge of the facts, statements, and matters herein contained and the log of the above-described well as filed and that the same are true and correct. So help me God.

(Signature) G. A. Reynolds

Box 7, Ellinwood, Kansas  
(Address)

SUBSCRIBED AND SWORN TO before me this 27th day of November, 19 56

My commission expires November 12, 1958

[Signature]  
Notary Public.

PLUGGING  
FILE SEC 19 T 23 R 15W  
BOOK PAGE 112 LINE 9



FORMATION RECORD

DESCRIBE EACH FORMATION DRILLED. INDICATE THICKNESS, CONTENT AND WHETHER DRY, OR OIL, GAS, OR WATER BEARING.

FORMATION	TOP	BOTTOM	FORMATION	TOP	BOTTOM
Sand	0	70			
Shale and shells	70	370			
Shale	370	425			
Red bed	425	905			
Anhydrite	905	1010			
Shale and shells	1010	3080			
Shale and lime	1980	2405			
Shale	2405	2705			
Shale and lime	2705	3278			
Lime	3278	3295			
Lime and shale	3295	3445			
Lime	3445	3497			
Heckner Top	3497				
Lime and shale	3497	3642			
Jenssen Top	3642				
Lime	3642	3658			
Lime with oil stains	3658	3674			
Lime	3674	3935			
Henderson Top	3935				
Lime	3935	4026			
Lime and chert	4026	4055			
Simons Top	4055				
Shale and chert	4055	4086			
Arbuckle Top	4086				
Cherty lime with shale	4086	4092			
Lime with gas shows	4092	4100			
Dela. Lime	4100	4250			
Run Schlumberger Elec. Logs to T.D.					
Total Depth:					
By Schlumberger		4250			
By Rotary Drill		4250			