


WELL PLUGGING RECORD

Give All Information Completely
Make Required Affidavit
Mail or Deliver Report to:
Conservation Division
State Corporation Commission
800 Bittling Building
Wichita, Kansas

Pawnee County, Sec. 20 Twp. 23S Rge. 15 (E) 15 (W)

Location as "NE/CNW&SW" or footage from lines NW NW SE
Lease Owner Musgrove Petroleum Corporation
Lease Name PARKS Well No. 1
Office Address 518 Petroleum Building, Wichita, Kansas
Character of Well (completed as Oil, Gas or Dry Hole) Dry hole
Date well completed October 19, 19 55
Application for plugging filed verbally - October 18, 19 55
Application for plugging approved verbally - October 18, 19 55
Plugging commenced October 19, 19 55
Plugging completed October 19, 19 55
Reason for abandonment of well or producing formation Dry

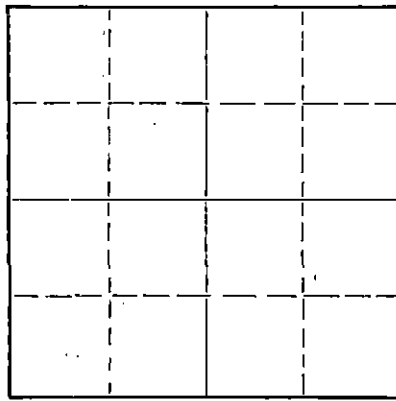

Locate well correctly on above Section Plat

If a producing well is abandoned, date of last production 19
Was permission obtained from the Conservation Division or its agents before plugging was commenced? verbally - yes

Name of Conservation Agent who supervised plugging of this well _____
Producing formation _____ Depth to top _____ Bottom _____ Total Depth of Well 4220' Feet
Show depth and thickness of all water, oil and gas formations.

OIL, GAS OR WATER RECORDS

CASING RECORD

FORMATION	CONTENT	FROM	TO	SIZE	PUT IN	PULLED OUT
				8-5/8"	360'	

Describe in detail the manner in which the well was plugged, indicating where the mud fluid was placed and the method or methods used in introducing it into the hole. If cement or other plugs were used, state the character of same and depth placed, from _____ feet to _____ feet for each plug set.

Filled hole with heavy mud to 300'
Set first plug at 300' with 1/3 sk hulls & 20 sx cement
Filled hole with heavy mud to 35'
Set second plug at 35' with 1/3 sk hulls & 10 sx cement

(If additional description is necessary, use BACK of this sheet)
Name of Plugging Contractor Musgrove Petroleum Corporation
Address 518 Petroleum Building, Wichita, Kansas

STATE OF Kansas COUNTY OF Sedgwick
I, Gordon L. Koelling, (employee of owner) or (owner/operator) of the above-described well, being first duly sworn on oath, says: That I have knowledge of the facts, statements, and matters herein contained and the log of the above-described well as filed and that the same are true and correct. So help me God.

(Signature) Gordon L. Koelling
518 Petroleum Building, Wichita, Kansas
(Address)

SUBSCRIBED AND SWORN TO before me this 25th day of October, 19 55

My commission expires June 16, 1959
Reed J. Hefke Notary Public.

PLUGGING
FILE SEC 20 T 23 R 15 S
BOOK PAGE 11 LINE 8

10-27-55

15-145-00390-0000

CONTRACTOR'S WELL LOG

COMPANY	Musgrove Petroleum Corporation
CONTRACTOR:	Musgrove Petroleum Corporation
FARM:	PARKS #1
LOCATION:	NW NW SE, Sec. 20-23S-15W Pawnee County, Kansas
COMMENCED:	October 5, 1955
COMPLETED:	October 19, 1955

0	97	Surface soil and sand
97	225	Shale & shells
225	400	Shale
400	1160	Red bed & shale
1160	1550	Red bed, shale & lime streaks
1550	1680	Shale & lime streaks
1680	3745	Shale & lime
3745	3885	Lime
3885	3955	Lime & shale
3955	4015	Lime
4015	4150	Lime, shale & chert
4150	4220	Cherty lime & shale
	4220	Rotary Total Depth

Set 8-5/8" surface casing at 360' with 225 sacks cement.

Dry and Abandoned

ELEVATION:	2040' K. B.	Lansing	3665
TOPS:		Base Kansas City	3911
Heebner	3520	Conglomerate	4032
Toronto	3545	Viola	Not registered
Douglas	3561	Simpson	4134
Brown Lime	3657	Arbuckle	4159

STATE OF KANSAS)
) SS
 COUNTY OF SEDGWICK)

I, GORDON L. KOELLING, do hereby certify that the above and foregoing is a true and correct copy of the log of the PARKS #1, NW NW SE, Section 20-23S-15W, Pawnee County, Kansas, as reflected by the files of the Musgrove Petroleum Corporation.

MUSGROVE PETROLEUM CORPORATION

BY: Gordon L. Koelling
 Secretary-Treasurer

Subscribed and sworn to before me, a Notary Public, in and for Sedgwick County, Kansas, this 25th day of October, 1955.

Reed Jay Neff
 Notary Public

My commission expires June 16, 1959.

PLUGGING
 FILE SEC 20 T 23 R 15 W
 DECK PAGE 11 LINES 8