


STATE OF KANSAS
STATE CORPORATION COMMISSION

WELL PLUGGING RECORD

Give All Information Completely
Make Required Affidavit
Mail or Deliver Report to:
Conservation Division
State Corporation Commission
211 No. Broadway
Wichita, Kansas

McPherson County. Sec. 14 Twp. 21 Rge. 2 (E) W (W)
Location as "NE/CNW/SW" or footage from lines SE SE NW
Lease Owner O. A. Sutton
Lease Name Vogt Well No. 1
Office Address 407 Insurance Building, Wichita, Kansas
Character of Well (completed as Oil, Gas or Dry Hole) Dry Hole
Date well completed 2-20 1958
Application for plugging filed 2-20 1958
Application for plugging approved 2-20 1958
Plugging commenced 2-20 1958
Plugging completed 2-20 1958
Reason for abandonment of well or producing formation D & A

NORTH

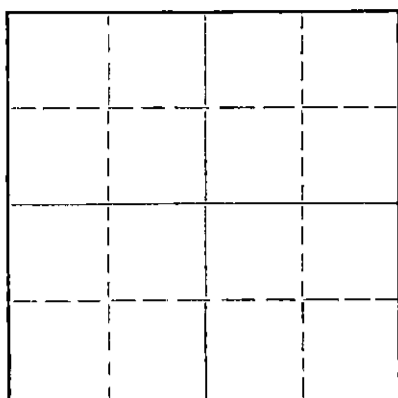

Locate well correctly on above
Section Plat

If a producing well is abandoned, date of last production _____ 19____
Was permission obtained from the Conservation Division or its agents before plugging was commenced? Yes

Name of Conservation Agent who supervised plugging of this well Ruel Durkee
Producing formation _____ Depth to top _____ Bottom _____ Total Depth of Well 3559 Feet
Show depth and thickness of all water, oil and gas formations.

OIL, GAS OR WATER RECORDS

CASING RECORD

FORMATION	CONTENT	FROM	TO	SIZE	PUT IN	PULLED OUT
				8 5/8	179	

Describe in detail the manner in which the well was plugged, indicating where the mud fluid was placed and the method or methods used in introducing it into the hole. If cement or other plugs were used, state the character of same and depth placed, from _____ feet to _____ feet for each plug set.

Filled w/ heavy mud from 3559 to 175'. Set plug @ 175, mixed 15 sacks cement thru 15 joints drill pipe. Filled w/ heavy mud from 125' to 25'. Set plug @ 25', mixed 5 sacks cement.

RECEIVED
STATE CORPORATION COMMISSION
FEB 24 1958
CONSERVATION DIVISION
Wichita, Kansas

(If additional description is necessary, use BACK of this sheet)
Name of Plugging Contractor J. S. Sutton & Sons
Address 407 Insurance Building, Wichita, Kansas

STATE OF KANSAS, COUNTY OF SEDGWICK, ss.
A. L. Rhodes (employee of owner) or (~~owner or operator~~) of the above-described well, being first duly sworn on oath, says: That I have knowledge of the facts, statements, and matters herein contained and the log of the above-described well as filed and that the same are true and correct. So help me God.

(Signature) [Signature]

(Address) _____

SUBSCRIBED AND SWORN TO before me this 21st day of February 1958

My commission expires December 31, 1958
Donna L. Riley Notary Public.

PLUGGING
FILE SEC. 14 T. 21 R. 2w
BOOK PAGE 84 LINE 37

O. A. Sutton, Vogts #1
 SE SE NW Sec. 14-21S-2W
 McPherson County, Kansas

Commenced - February 8, 1958
 Completed - February 20, 1958
 Elevation - 1499 Kelly Bushing
 Casing - 179' of 8-5/8" w/125 sacks common 2% chloride

DRILLERS LOG

0 -	-20	Surface
20 -	90	Sand and shale
90 -	179	Shale and shells
179 -	350	Shale and shells
350 -	585	Shale and lime
585 -	805	Lime and shale
805 -	1060	Shale and lime
1060 -	1415	Shale and shells
1415 -	1660	Shale and lime
1660 -	1910	Shale (sandy)
1910 -	2030	Lime
2030 -	2252	Shale and lime (sand)
2252 -	2265	Lime
2265 -	2364	Lime
2364 -	2432	Lime
2432 -	2526	Lime
2526 -	2600	Lime
2600 -	2662	Lime
2662 -	2752	Lime and shale
2752 -	2852	Shale and lime
2852 -	2938	Lime and shale
2938 -	2959	Shale (conгло)
2959 -	2968	Miss. (chert)
2968 -	3025	Miss. (chert)
3025 -	3062	Miss. (lime)
3062 -	3097	Miss. (chert)
3097 -	3130	Miss. (chert)
3130 -	3156	Miss. (lime)
3156 -	3170	Kinderhook
3170 -	3207	Kinderhook
3207 -	3280	Lime and shale
3280 -	3368	Lime and shale
3368 -	3421	Lime and shale
3421 -	3425	Viola
3425 -	3435	Viola
3435 -	3446	Viola
3446 -	3469	Simpson
3469 -	3483	Simpson
3483 -	3523	Simpson
3523 -	3535	Simpson
3535 -	3559	Arbuckle
3559 -		Rotary Total Depth

RECEIVED

STATE CORPORATION COMMISSION

FEB 24 1958

CONSERVATION DIVISION
 Wichita, Kansas

STATE OF KANSAS)
) SS
 SEDGWICK COUNTY)

I, the undersigned, being duly sworn on oath, state that the above Drillers Log is true and correct to the best of my knowledge and belief and

PLUGGING
 FILE SEC 14 T 21 R 2W
 BOOK PAGE 84 LINE 37

according to the records of this office.

J. S. SUTTON & SONS DRILLING CO.

By Henry D. Ficker

Subscribed and sworn to before me this 21st day of February, 1958.

Lorraine Shullcutt
Notary Public

My commission expires June 1, 1960.

RECEIVED
DIVISION OF COMMISSION

FEB 24 1958

DIVISION

PLUGGING
FILE SEC. 14 T. 21 R. 20
BOOK PAGE 04 LINE 37