

STATE OF KANSAS
STATE CORPORATION COMMISSION

WELL PLUGGING RECORD

Give All Information Completely
Make Required Affidavit
Mail or Deliver Report to
Conservation Division
State Corporation Comm.
245 North Water
Wichita, KS 67202

McPherson County, Sec. 21 Twp. 21 Rge. 2W E/W
Location as "NE/CNW $\frac{1}{4}$ /SW $\frac{1}{4}$ " or footage from lines
NE NE SE

Lease Owner John J. Darrah
Lease Name Goering Well No. 1

Office Address 1010 Century Plaza Bldg., Wichita, Ks. 67202
Character of Well (Completed as Oil, Gas or Dry Hole)

Dry

Date Well completed January 25, 1980

Application for plugging filed 19

Application for plugging approved 19

Plugging commenced 19

Plugging completed January 25, 1980

Reason for abandonment of well or producing formation

Dry


If a producing well is abandoned, date of last production 19

Was permission obtained from the Conservation Division or its agents before plugging was commenced? Yes

Name of Conservation Agent who supervised plugging of this well Gilbert Toman

Producing formation Depth to top Bottom Total Depth of Well

Show depth and thickness of all water, oil and gas formations.

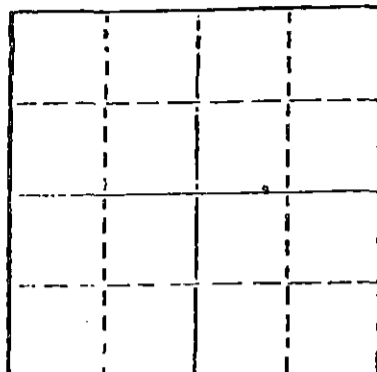

Locate well correctly on above Section Plot

OIL, GAS OR WATER RECORDS

CASING RECORD

FORMATION	CONTENT	FROM	TO	SIZE	PUT IN	PULLED OUT
Clay		0	95	8 5/8"	95'	None
Shale		95'	168'	8 5/8"	73'	None

Describe in detail the manner in which the well was plugged, indicating where the mud fluid was placed and the method or methods used in introducing it into the hold. If cement or other plugs were used, state the character of same and depth placed, from feet to feet for each plug set.

Filled hole to 165' and set plug with 25 sacks of cement. Filled hole with mud to 40' and set plug with 10 sacks of cement, 2 sacks in rathole. Plugging completed at 9:00 P. M., January 25, 1980. Plugging completed by State Plugger, Gilbert Toman, Holyrood, Kansas.

STATE RECEIVED
 STATE RECEIVED
 FEB - 4 1980
 2-4-80
 JAN 31 1980
 (If additional description is necessary, use BACK of this sheet)
 Name of Plugging Contractor Blackstone Drilling, Inc.

STATE OF Kansas COUNTY OF Sedgwick, ss.
John J. Darrah (employee of owner) or (owner or operator)
of the above-described well, being first duly sworn on oath, says: That I have knowledge of the facts, statements, and matters herein contained and the log of the above-described well as filed and that the same are true and correct. So help me God.

(Signature) John J. Darrah
1010 Century Plaza Bldg., Wichita, Kansas 67202
(Address)

SUBSCRIBED AND SWORN TO before me this 2nd day of February, 1980

Jeanne C. Kepner
Jeanne C. Kepner, Notary Public

My commission expires

