

15.009.00156.00.01

RECEIVED  
STATE CORPORATION COMMISSION

DEC 30 1974

STATE OF KANSAS  
STATE CORPORATION COMMISSION  
CONSERVATION DIVISION  
P. O. BOX 17027  
WICHITA, KANSAS 67217

FORM CP-4

WELL PLUGGING RECORD  
Conservation Division  
Wichita, Kansas

Barton County, Sec. 20 Twp. 18S Rge. 13W (E) (W)

Location as "NE/CNW/SW" or footage from lines. SE SE NE 330'

Lease Owner L. R. Smith

Lease Name Smith Well No. 1

Office Address P. O. 414, Hoisington, Kansas 67544

Character of Well (completed as Oil, Gas or Dry Hole) Dry Hole

Date well completed 10/09/1974

Application for plugging filed 10/09/1974

Application for plugging approved 10/09/1974


Plugging commenced 10/09/1974

Plugging completed 10/09/1974

Reason for abandonment of well or producing formation Dry Hole

If a producing well is abandoned, date of last production 19

Was permission obtained from the Conservation Division or its agents before plugging was commenced? YES

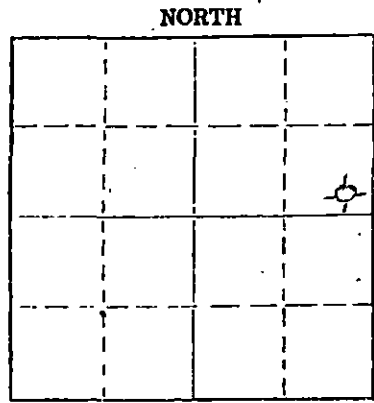

Locate well correctly on above Section Flat

Name of Conservation Agent who supervised plugging of this well J. Lewis Brock

Producing formation \_\_\_\_\_ Depth to top \_\_\_\_\_ Bottom \_\_\_\_\_ Total Depth of Well 1850 Feet

Show depth and thickness of all water, oil and gas formations. This was a re-entry of an old hole drilled 2/52.

OIL, GAS OR WATER RECORDS

CASING RECORD

FORMATION	CONTENT	FROM	TO	SIZE	PUT IN	PULLED OUT

Describe in detail the manner in which the well was plugged, indicating where the mud fluid was placed and the method or methods used in introducing it into the hole. If cement or other plugs were used, state the character of same and depth placed, from \_\_\_\_\_ feet to \_\_\_\_\_ feet for each plug set.

Set plug @ 260' with 15 sacks cement

Set plug @ 40' with 1/2 sack hulls & 10 sacks cement

(If additional description is necessary, use BACK of this sheet)

Name of Plugging Contractor Sun Oilwell Cementing, Inc.

Address P. O. Box 169, Great Bend, Kansas 67530

State of Kansas COUNTY OF Barton, ss.

Lawrence R. Smith (employee of owner) or (owner or operator) of the above-described

well, being first duly sworn on oath, says: That I have knowledge of the facts, statements and matters herein contained and the log of the above-described well as filed and that the same are true and correct. So help me God.

(Signature) Lawrence R. Smith

P.O. Box 414 Hoisington

(Address)

Subscribed and sworn to before me this 30th day of December, 19 74

My commission expires September 13, 1977

Margaret B. Krug Notary Public

