


15.009.00/56.00.00
WELL PLUGGING RECORD

Give All Information Completely
Make Required Affidavit
Mail or Deliver Report to:
Conservation Division
State Corporation Commission
800 Bittling Building
Wichita, Kansas

Barton County, Sec. 20 Twp. 18 Rge. 13W (E) (W)

Location as "NE/CNW $\frac{1}{4}$ SW $\frac{1}{4}$ " or footage from lines SE SE NE
Lease Owner John Lindas Oil, Inc.
Lease Name Smith Well No. 1
Office Address 1316 Union National Bank Building, Wichita, Kansas
Character of Well (completed as Oil, Gas or Dry Hole) Dry Hole
Date well completed 2-22-1952
Application for plugging filed 2-22-1952
Application for plugging approved 2-22-52
Plugging commenced 2-22-1952
Plugging completed 2-22-1952
Reason for abandonment of well or producing formation Dry Hole

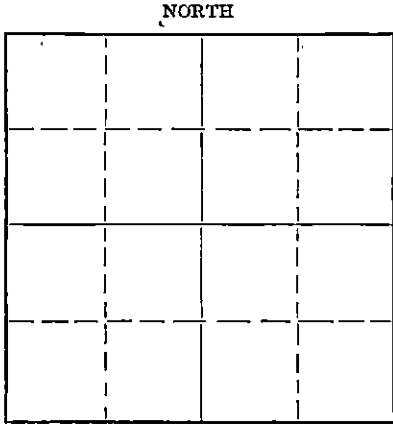

Locate well correctly on above Section Plat

If a producing well is abandoned, date of last production 19
Was permission obtained from the Conservation Division or its agents before plugging was commenced? Yes.

Name of Conservation Agent who supervised plugging of this well Harold Hollis
Producing formation _____ Depth to top _____ Bottom _____ Total Depth of Well 3380' Feet
Show depth and thickness of all water, oil and gas formations.

OIL, GAS OR WATER RECORDS CASING RECORD

Formation	Content	From	To	Size	Put In	Pulled Out
				8-5/8"	760'	Cemented

Describe in detail the manner in which the well was plugged, indicating where the mud fluid was placed and the method or methods used in introducing it into the hole. If cement or other plugs were used, state the character of same and depth placed, from _____ feet to _____ feet for each plug set.

760' 8-5/8" casing set plug @ 260' with 15 sacks cement.
Set plug @ 40' with 1/2 sack hulls and 10 sacks cement.

(If additional description is necessary, use BACK of this sheet)

Name of Plugging Contractor John Lindas Oil Inc.
Address 1316 Union National Bank Building, Wichita, Kansas

STATE OF Kansas, COUNTY OF Sedgwick, ss.
Fred Moore (employee of owner) or (owner or operator) of the above-described well,

being first duly sworn on oath, says: That I have knowledge of the facts, statements, and matters herein contained and the log of the above-described well as filed and that the same are true and correct. So help me God.

(Signature) Fred Moore Drilling Superintendent
W. Bend, Kansas
(Address)

SUBSCRIBED AND SWORN to before me this 25th day of February, 19 52
Edward W. Collins
Notary Public.

My commission expires October 8, 1956
23-8390-s 6-51-20M

2-28-52

PLUGGING
FILE SEC 20 T 18 R 34
PAGE 147 LINE 4

15.009.00/56.00.00

DRILLING LOG

Lease: Smith #1

County: Barton
Location: SE/14 SE/14 NE/14
Section: 20-18S-13W
Elevation: 1822' DF 1825' KB
Production: Dry and Abandoned

Rotary Total Depth: 3380'
Commenced: 2-9-52
Completed: 2-23-52
Casing: 8-5/8" @ 759' w/375 sacks of cement and
4 sacks of Calcium Chloride.

CONTRACTOR: JOHN LINDAS OIL, INC.
1316 Union National Bank Bldg.
Wichita 2, Kansas

FIGURES INDICATE BOTTOM OF FORMATION

0	50	Soil and Sand (Surface)
50	310	Shale and Sand Streak
310	340	Dakota Sand
340	420	Red Bed and Shale
420	740	Red Bed
740	749	Red Rock
749	784	Anhydrite
784	1210	Shale and Shells
1210	1320	Salt and Shale
1320	1625	Shale, Shell and Lime
1625	1755	Lime and Shale Streak
1755	1865	Lime and Shale
1865	1955	Lime
1955	2050	Lime and Shale
2050	2250	Lime and Shale Streak
2250	2395	Lime and Shale
2395	2715	Shale and Shells
2715	2795	Shale and Lime
2795	2815	Lime
2815	2890	Lime and Shale
2890	3015	Lime
3015	3380	Lime TD

STATE OF KANSAS)
)SS:
COUNTY OF SEDGWICK)

I, the undersigned, being duly sworn on oath, state that the above statement and log is a true and correct record of the well drilled by John Lindas Oil, Inc., at the location above described.

Edward W. Vienna

Subscribed and sworn to before me, this 4th day of March, 1952.

Catherine Carney

My commission expired March 25, 1952

PLUGGING
FILE SEC 20 T 11 R 13 W
PAGE 14 LINE 4

MAR 5 - 1952