

STATE OF KANSAS
STATE CORPORATION COMMISSION


15.009.06226.00.00
WELL PLUGGING RECORD

Give All Information Completely
Make Required Affidavit
Mail or Deliver Report to:
Conservation Division
State Corporation Commission
800 Bittling Building
Wichita, Kansas

Barton County, Sec. 24 Twp. 18 Rge. 11 (W) (W)

Location as "NE/CNW $\frac{1}{4}$ SW $\frac{1}{4}$ " or footage from lines S $\frac{1}{2}$ NW SE
Lease Owner El Dorado Refining Co.
Lease Name Stumps Well No. 2
Office Address Russell, Kansas
Character of Well (completed as Oil, Gas or Dry Hole) D & A
Date well completed 5-19 19 50
Application for plugging filed 6-15 19 50
Application for plugging approved 19
Plugging commenced 5-19 19 50
Plugging completed 5-19 19 50
Reason for abandonment of well or producing formation D & A

NORTH

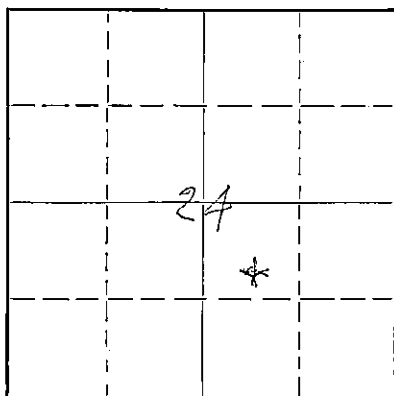

Locate well correctly on above Section Plat

If a producing well is abandoned, date of last production 19
Was permission obtained from the Conservation Division or its agents before plugging was commenced? Yes

Name of Conservation Agent who supervised plugging of this well Slough Great Bend
Producing formation Depth to top Bottom Total Depth of Well 3328 Feet
Show depth and thickness of all water, oil and gas formations.

OIL, GAS OR WATER RECORDS

CASING RECORD

Formation	Content	From	To	Size	Put In	Pulled Out
Surface		-0-	555	8 5/8	555	-0-
		Cemented to surface.				

Describe in detail the manner in which the well was plugged, indicating where the mud fluid was placed and the method or methods used in introducing it into the hole. If cement or other plugs were used, state the character of same and depth placed, from feet to feet for each plug set.

Filled hole with heavy mud to 555'
15 sax cement at 555'
10 sax cement at surface

6-16-60

RECEIVED
JUN 16 1956

(If additional description is necessary, use BACK of this sheet)

Correspondence regarding this well should be addressed to El Dorado Refining Co.
Address Wichita, Kansas

STATE OF Kansas, COUNTY OF Sedgwick, ss.
Chester Williams (employee of owner) or (owner or operator) of the above-described well,
being first duly sworn on oath, says: That I have knowledge of the facts, statements, and matters herein contained and the log of the above-described well as filed and that the same are true and correct. So help me God.


(Signature) *Chester Williams*

(Address)

SUBSCRIBED AND SWORN to before me this 14th day of June 1956

Maurine L. Shreve
Notary Public.

My commission expires

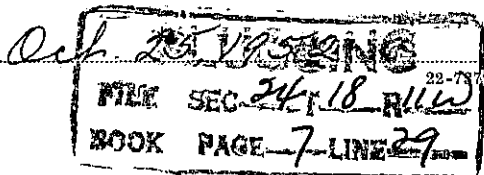

4-49-10M

WELL LOG

Eldorado Refining Co. Et Al

Stumps #2

Flournoy & Williams Tools

C S $\frac{1}{2}$ NW SE

24-18-11W

Barton Co., Kansas

D & A

Commenced 5-10-50

Completed 5-21-50

Casing 555' 8 5/8

<u>Formation</u>	<u>R. Bushing Depth</u>	<u>D. F. Tops</u>	
Clay	30		
Sandy shale	140		
Red bed & shells	548		
Anhydrite	575		
Red bed & shale	610		
Shale & shells	1095	Heebner	2872
Salt	1190	Dodge Lime	2891
Shale & Lime shells	1590	Brown Lime	2986
Shale & lime	2670	Lansing	3005
Lime	3300	Cherty Conglomerate	3296
Conglomerate	3320	Arbuckle	3318
Arbuckle	3330	T. D.	3328
		T.D.	

STATE OF KANSAS)
) SS:
 SEDGWICK COUNTY)

Chester Williams of lawful age being first duly sworn on his oath states that the above formations and depths are true and correct as taken from the daily drilling log of the Stumps No. 2 Well in the C S $\frac{1}{2}$ NW SE 24-18-11W, Barton County, Kansas.

PLUGGING
 FILE SEC 24-T-18-R-11W
 BOOK PAGE 7 LINE 29

Chester Williams

Subscribed and sworn to before me this 14th day of June, 1950.

Maurine L Shiever
 Notary Public